

SURVEY & REMONUMENTATION

MAY 24 2000

LIBR 19237PG838

SECTION

LAND CORNER RECORDATION CERTIFICATE
Filing Requirement of Act 74, Mich. P.A. 1970

\$ 9.00 MISCELLANEOUS RECORDING
\$ 2.00 REMONUMENTATION
4 DEC 98 8:29 A.M. RECEIPT# 48
PAID RECORDED - OAKLAND COUNTY
G. WILLIAM CADDELL
CLERK/REGISTER OF DEEDS

10E-498347616

For corners in Oakland _____ Located In: _____ Corner Code # _____
(County) _____

1. Public Land Survey T 4N R 8E A-4
T R
T R
T R

2. Property Controlling in Section S T R
S T R
S T R

3. Miscellaneous Property in Sec. S T R

4. Lot No. _____, Recorded Plat _____

5. Private Claims _____

Compliance with ACT 345, P.A. 1990
APPROVED ON: 3-24-98 JS
OAKLAND COUNTY REMONUMENTATION PEER GROUP COMMITTEE
Register of Deeds Stamp & File Number

Grant J. Ward, R.L.S. December 19 97
I, _____, in a field survey on _____, 19 _____ do hereby state that under requirements of P.A. 74, Michigan P.A. of 1970, the corner points mentioned in lines 1 and 2 above were in conformance with regulations and rules therefore as required in the current manual of survey instructions of the United States Department of the Interior, Bureau of Land Management or by a decree of a Court of Law and/or that the corner points mentioned in lines 3, 4 and 5 above were in conformance with the rules of the Michigan Board of Land Surveyors or by a Decree of a Court of Law, established, re-established, monumented, recovered, found as expressed below:

NOTE: Not more than 2 corners, all in the same town and range, may be recorded on this certificate.

A	B	C	D	E	F	G	H	I	J	K	L	M
1												
2	6	5	4	3	2	1						
3												
4	7	8	9	10	11	12						
5												
6	10	17	16	15	14	13						
7												
8	19	20	21	22	23	24						
9												
10	30	29	28	27	26	25						
11												
12	31	32	33	34	35	36						
13												

A. Description of original monument and accessories and/or subsequent restoration:

A-4 Post, per G.L.O. Notes.

B. Description of corner evidence found and/or method applied in restoring or reestablishing corner:


A-4 West 1/4 Corner of Section 7, T. 4 N., R. 8 E. Found 3/4" Iron Pipe.
Previously Unrecorded.

This corner location, although not established by an original government survey, is accepted by the contractor and is generally accepted by professional surveyors as the best available evidence of the position of the corner.

900 FILE
200

C. Description of monument for corner and accessories established to perpetuate locating the position of the corner:

- A-4 Set Monument & Remonumentation Cap. Found 3/4" Iron Pipe.
- South 135.72' Set Monument & Remonumentation Cap. East 1/4 Corner Section 12, T. 4 N., R. 7 E., Rose Twp.
- South 245.56' Set MAG Nail & Remonumentation Disc in South face of 8" Tamarack.
- S 75° W 145.63' Set MAG Nail & Remonumentation Disc in North face of 10" Tamarack.
- N 85° W 156.22' Set MAG Nail & Remonumentation Disc in East face of 8" Tamarack.
- N 30° W 186.12'

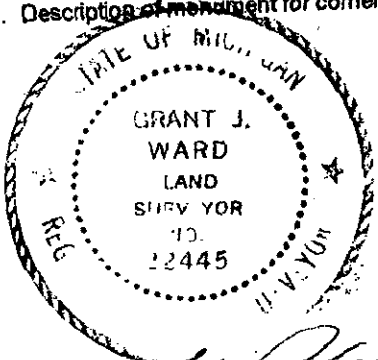

Signed by _____
Surveyor's Michigan License No. 22445

Date March 20, 1998