

MAY 24 2000

LIRFR 19237PC840

DE-4 98 34 7617

SECTION

LAND CORNER RECORDATION CERTIFICATE  
Filing Requirement of Act 74, Mich. P.A. 1970

For corners in

Oakland (County)	Located In:	Corner Code #
1. Public Land Survey	T 4N R 8E	A-5
	T R	
	T R	
	T R	
2. Property Controlling in Section	S T R	
	S T R	
3. Miscellaneous Property in Sec.	S T R	
	S T R	

\$ 9.00 MISCELLANEOUS RECORDING  
\$ 2.00 REMONUMENTATION  
4 DEC 98 8:29 A.M. RECEIPT# 48  
PAID RECORDED - OAKLAND COUNTY  
G. WILLIAM CARDELL  
CLERK/REGISTRAR OF DEEDS

Compliance with  
ACT 345, P.A. 1990  
APPROVED ON: 3-24-98 JS  
OAKLAND COUNTY REMONUMENTATION  
PEER GROUP COMMITTEE

Register of Deeds Stamp & File Number

4. Lot No. \_\_\_\_\_, Recorded Plat \_\_\_\_\_  
5. Private Claims \_\_\_\_\_

I, Grant J. Ward, R.L.S., in a field survey on December 17, 1997 do hereby state that under requirements of P.A. 74, Michigan P.A. of 1970, the corner points mentioned in lines 1 and 2 above were in conformance with regulations and rules therefore as required in the current manual of survey instructions of the United States Department of the Interior, Bureau of Land Management or by a decree of a Court of Law and/or that the corner points mentioned in lines 3, 4 and 5 above were in conformance with the rules of the Michigan Board of Land Surveyors or by a Decree of a Court of Law; established, re-established, monumented, recovered, found as expressed below:

	A	B	C	D	E	F	G	H	I	J	K	L	M
1													
2	6		5		4		3		2		1		
3													
4	7		8		9		10		11		12		
5													
6	18		17		16		15		14		13		
7													
8	19		20		21		22		23		24		
9													
10	30		29		28		27		26		25		
11													
12	31		32		33		34		35		36		
13													

NOTE: Not more than 2 corners, all in the same town and range, may be recorded on this certificate.

A. Description of original monument and accessories and/or subsequent restoration:  
A-5 Post, per G.L.O. Notes.

B. Description of corner evidence found and/or method applied in restoring or reestablishing corner:  
A-5 Northwest Corner of Section 18, T. 4 N., R. 8 E. Found 1/2" Iron Rod & "WARD" Cap.  
Previously Recorded in L. 10017 P. 818 (4) of Oakland County Records.


(n) Indicates the number of references that confirms this corner by dimensional tie.

This corner location is accepted by the contractor and is generally accepted by professional surveyors as the best available evidence of the position of the original corner.

9<sup>th</sup> FILE  
2<sup>nd</sup>

C. Description of monument for corner and accessories established to perpetuate locating the position of the corner:

- A-5 Set Monument and Remonumentation Cap.
- N 35° E 22.93' Set MAG Nail & Remonumentation Disc in West face of 10" Hickory
- N 80° E 16.54' Set MAG Nail & Remonumentation Disc in North face of 14" Hickory.
- N 75° E 36.09' Set MAG Nail & Remonumentation Disc in North face of 24" Oak.
- S 40° E 41.36' Set MAG Nail & Remonumentation Disc in Northeast face of 18" Oak.
- S 85° E 4.46' Found Monument with "WARD" Cap.

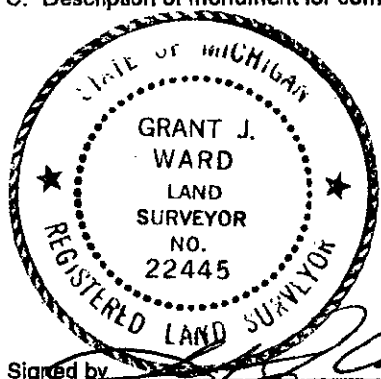

Signed by \_\_\_\_\_  
Surveyor's Michigan License No. 22445

Date February 17, 1998