

SURVEY & REMONUMENTATION

MAY 24 2000

LIBFR 19237PG842

10E-498347B18

LAND CORNER RECORDATION CERTIFICATE 9.00 MISCELLANEOUS RECORDING
 Filing Requirement of Act 74, Mich. P.A. 1970 \$ 2.00 REMONUMENTATION

4 DEC 98 8:29 A.M. RECEIPT# 48
 PAID RECORDED - OAKLAND COUNTY
 G. WILLIAM CAHOELL
 CLERK/REGISTER OF DEEDS

SECTION
 For corners in

Oakland (County)	Located In:	Corner Code #
1. Public Land Survey	T 4N R 8E	A-6
	T R	
	T R	
	T R	
2. Property Controlling in Section	S T R	
	S T R	
3. Miscellaneous Property in Sec.	S T R	
	S T R	
4. Lot No. _____, Recorded Plat _____		
5. Private Claims _____		

Compliance with ACT 345, P.A. 1990
 APPROVED ON: 3-24-98-55
 OAKLAND COUNTY REMONUMENTATION PEER GROUP COMMITTEE
 Register of Deeds Stamp & File Number

Grant J. Ward, R.L.S., January 17 98
 I, _____, in a field survey on _____, 19____ do hereby state that under requirements of P.A. 74, Michigan P.A. of 1970, the corner points mentioned in lines 1 and 2 above were in conformance with regulations and rules therefore as required in the current manual of survey instructions of the United States Department of the Interior, Bureau of Land Management or by a decree of a Court of Law and /or that the corner points mentioned in lines 3, 4 and 5 above were in conformance with the rules of the Michigan Board of Land Surveyors or by a Decree of a Court of Law; established, re-established, monumented, recovered, found as expressed below:

A	B	C	D	E	F	G	H	I	J	K	L	M
1												
2	6	5	4	3	2	1						
3												
4	7	8	9	10	11	12						
5												
6	18	17	16	15	14	13						
7												
8	19	20	21	22	23	24						
9												
10	30	29	28	27	26	25						
11												
12	31	32	33	34	35	36						
13												

NOTE: Not more than 2 corners, all in the same town and range, may be recorded on this certificate.

A. Description of original monument and accessories and/or subsequent restoration:

A-6 Post, per G.L.O. Notes.

B. Description of corner evidence found and/or method applied in restoring or reestablishing corner:

A-6 West 1/4 Corner of Section 18, T. 4 N., R. 8 E. Found 1/2" Iron Rod & Cap "WARD".

Previously Recorded in L. 10017 P. 818 (4) of Oakland County Records.


(n) Indicates the number of references that confirms this corner by dimensional tie.

This corner location, although not established by an original government survey, is accepted by the contractor and is generally accepted by professional surveyors as the best available evidence of the position of the original corner.

900 file

C. Description of monument for corner and accessories established to perpetuate locating the position of the corner:

- A-6 Set Monument and Remonumentation Cap.
- North 19.67' Set MAG Nail & Remonumentation Disc in East face of 12" Ash.
- N 70° E 13.86' Set MAG Nail & Remonumentation Disc in South face of 6" Oak.
- S 70° W 11.07' Set MAG Nail & Remonumentation Disc in Southeast face of 24" Ash.
- N 35° W 16.25' Set MAG Nail & Remonumentation Disc in Northeast face of 12" Cherry.
- South 235.73 Found 1/2" Iron Rod, M-6 Rose Township.

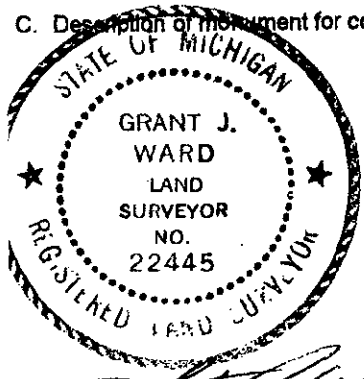

Signed by _____
 Surveyor's Michigan License No. 22445

Date March 24, 1998