

MAY 24 2000

LIBR 19237PC844

DE-4 98 34 76 19

SECTION

LAND CORNER RECORDATION CERTIFICATE
Filing Requirement of Act 74, Mich. P.A. 1970

For corners in

Oakland

(County)

Located in:

Corner Code #

- 1. Public Land Survey T 4N R 8E A-7
- T R
- T R
- T R
- 2. Property Controlling S T R
- in Section S T R
- 3. Miscellaneous S T R
- Property in Sec. S T R

\$ 9.00 MISCELLANEOUS RECORDING
 \$ 2.00 REMONUMENTATION
 4 DEC 98 8:30 A.M. RECEIPT# 48-19
 PAID RECORDED - OAKLAND COUNTY
 G. WILLIAM CADDELL
 CLERK/REGISTER OF DEEDS

Compliance with
ACT 345, P.A. 1990

APPROVED ON: 3-24-98-JS
 OAKLAND COUNTY REMONUMENTATION
 PEER GROUP COMMITTEE

Register of Deeds Stamp & File Number

- 4. Lot No. _____, Recorded Plat _____
- 5. Private Claims _____

Grant J. Ward, R.L.S. January 17 98
 I, _____, in a field survey on _____ 19____ do hereby state that under requirements of P.A. 74, Michigan P.A. of 1970, the corner points mentioned in lines 1 and 2 above were in conformance with regulations and rules therefore as required in the current manual of survey instructions of the United States Department of the Interior, Bureau of Land Management or by a decree of a Court of Law and/or that the corner points mentioned in lines 3, 4 and 5 above were in conformance with the rules of the Michigan Board of Land Surveyors or by a Decree of a Court of Law; established, re-established, monumented, recovered, found as expressed below:

NOTE: Not more than 2 corners, all in the same town and range, may be recorded on this certificate.

A	B	C	D	E	F	G	H	I	J	K	L	M
1												
2	6	5	4	3	2	1						
3												
4	7	8	9	10	11	12						
5												
6	18	17	16	15	14	13						
7												
8	19	20	21	22	23	24						
9												
10	30	29	28	27	26	25						
11												
12	31	32	33	34	35	36						
13												

A. Description of original monument and accessories and/or subsequent restoration:

A-7 Post, per G.L.O. Notes.

B. Description of corner evidence found and/or method applied in restoring or reestablishing corner:

A-7 Northwest Corner of Section 19, T. 4 N., R. 8 E. Found Monument.


Previously Recorded in L. 7031 P. 677 (3) and L. 10264 P. 551 (4) of Oakland County Records.

(n) Indicates the number of references that confirms this corner by dimensional tie.

This corner location is accepted by the contractor and is generally accepted by professional surveyors as the best available evidence of the position of the original corner.

C. Description of monument for corner and accessories established to perpetuate locating the position of the corner:

- A-7 Set Monument and Remonumentation Cap.
- N 55° E 36.76' Set MAG Nail & Remonumentation Disc in East face of 36" Oak.
- East 22.96' Set MAG Nail & Remonumentation Disc in North face of 24" Oak.
- S 25° E 27.25' Set MAG Nail & Remonumentation Disc in Southeast face of 24" Oak.
- N 75° W 46.93' Set MAG Nail & Remonumentation Disc in South face of 14" Cherry.
- South 198.12' Found 1/2" Iron Rod, M-7 Rose Township
- West 7.39' Found Monument.

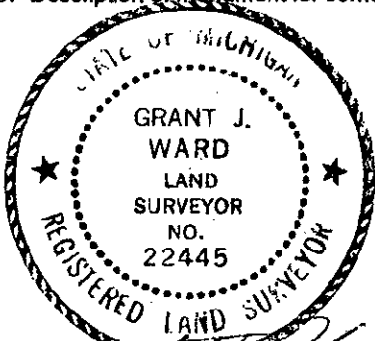

Signed by _____
 Surveyor's Michigan License No. 22445

Date March 24, 1998

G.W. FILE