

MAY 24 2000

LIBER 19237 PC 846

10E-4 98 347620

SECTION

LAND CORNER RECORDATION CERTIFICATE
Filing Requirement of Act 74, Mich. P.A. 1970

For corners in	Located in:	Corner Code #
Oakland (County)		
1. Public Land Survey	T 4N R 8E	A-8
	T R	
	T R	
	T R	
	T R	
2. Property Controlling in Section	S T R	
	S T R	
3. Miscellaneous Property in Sec.	S T R	
	S T R	

\$ 9.00 MISCELLANEOUS RECORDING
 \$ 2.00 REMONUMENTATION
 4 DEC 98 8:30 A.M. RECEIPTS 48
 PAID RECORDED - OAKLAND COUNTY
 G. WILLIAM CADWELL
 CLERK/REGISTER OF DEEDS
 Compliance with
 ACT 345, P.A. 1990
 APPROVED ON: 3-24-98 JS
 OAKLAND COUNTY REMONUMENTATION
 PEER GROUP COMMITTEE
 Register of Deeds Stamp & File Number

4. Lot No. _____, Recorded Plat _____
 5. Private Claims _____

I, Grant J. Ward, R.L.S., in a field survey on March 20, 1998 do hereby state that under requirements of P.A. 74, Michigan P.A. of 1970, the corner points mentioned in lines 1 and 2 above were in conformance with regulations and rules therefore as required in the current manual of survey instructions of the United States Department of the Interior, Bureau of Land Management or by a decree of a Court of Law and for that the corner points mentioned in lines 3, 4 and 5 above were in conformance with the rules of the Michigan Board of Land Surveyors or by a Decree of a Court of Law; established, re-established, monumented, recovered, found as expressed below:

NOTE: Not more than 2 corners, all in the same town and range, may be recorded on this certificate.

	A	B	C	D	E	F	G	H	I	J	K	L	M
1													
2	6		5		4		3		2		1		
3													
4	7		8		9		10		11		12		
5													
6	18		17		16		15		14		13		
7													
8	19		20		21		22		23		24		
9													
10	30		29		28		27		26		25		
11													
12	31		32		33		34		35		36		
13													

A. Description of original monument and accessories and/or subsequent restoration:

A-8 Post, per G.L.O. Notes.

B. Description of corner evidence found and/or method applied in restoring or reestablishing corner:


A-8 West 1/4 Corner of Section 19, T. 4 N., R. 8 E. Found Iron Rod & Obliterated Cap.
 Previously Recorded in L. 10030 P. 462 (4) of Oakland County Records.

(n) Indicates the number of references that confirms this corner by dimensional tie.

This corner location, although not established by an original government survey, is accepted by the contractor and is generally accepted by professional surveyors as the best available evidence of the position of the original corner.

C. Description of monument for corner and accessories established to perpetuate locating the position of the corner:

- A-8 Set Monument and Remonumentation Cap.
- N 75° E 9.88' Set MAG Nail & Remonumentation Disc in South face of 20" Oak.
- East 9.19' Set MAG Nail & Remonumentation Disc in North face of 6" Hickory.
- S 65° E 13.48' Set MAG Nail & Remonumentation Disc in North face of 8" Hickory.
- S 15° E 18.17' Set MAG Nail & Remonumentation Disc in Northeast face of 34" Oak.
- South 184.49' Found 1/2" Iron Rod & "WARD" Cap, East 1/4 Corner, Sec. 24, Rose Twp.

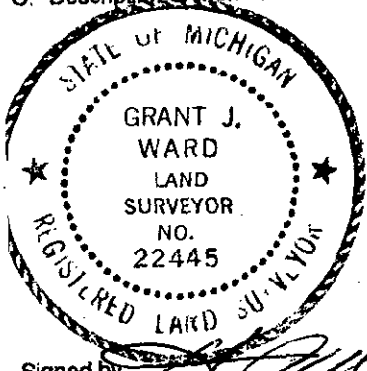

Signed by _____
 Surveyor's Michigan License No. 22445

Date March 24, 1998