

SURVEY & REMONUMENTATION

MAY 24 2000

LIBER 19832PG749

SECTION

LAND CORNER RECORDATION CERTIFICATE
Filing Requirement of Act 74, Mich. P.A. 1970

128318

For corners in

Oakland

(County)

Located in:

Corner Code #

LIBER 19832 PAGE 749
\$9.00 MISC RECORDING
\$2.00 REMONUMENTATION
04/14/1999 01:54:01 P.M. RECEIPT# 18962
PAID RECORDED - OAKLAND COUNTY
G. WILLIAM CADDELL, CLERK/REGISTER OF DEE

Compliance with
ACT 345, P.A. 1990

APPROVED ON: 2-10-99 JS
OAKLAND COUNTY REMONUMENTATION
PEER GROUP COMMITTEE

Register of Deeds Stamp & File Number

1. Public Land Survey

T 4N R 8E A-11

2. Property Controlling
in Section

S T R

3. Miscellaneous
Property in Sec.

S T R

4. Lot No. _____, Recorded Plat _____

5. Private Claims _____

I, Grant J. Ward, R.L.S., in a field survey on August 25, 1998 do hereby state that under requirements of P.A. 74, Michigan P.A. of 1970, the corner points mentioned in lines 1 and 2 above were in conformance with regulations and rules therefore as required in the current manual of survey instructions of the United States Department of the Interior, Bureau of Land Management or by a decree of a Court of Law and/or that the corner points mentioned in lines 3, 4 and 5 above were in conformance with the rules of the Michigan Board of Land Surveyors or by a Decree of a Court of Law; established, re-established, monumented, recovered, found as expressed below:

NOTE: Not more than 2 corners, all in the same town and range, may be recorded on this certificate.

A. Description of original monument and accessories and/or subsequent restoration:

A-11 Post, per G.L.O. Notes.

B. Description of corner evidence found and/or method applied in restoring or reestablishing corner:

A-11 Northwest Corner of Section 31, T. 4 N., R. 8 E. Found Iron Rod & Cap #22445.


Previously Recorded in L. 11201 P. 212 (4) of Oakland County Records.

(n) Indicates the number of references that confirms this corner by dimensional tie.

This corner location is accepted by the contractor and is generally accepted by professional surveyors as the best available evidence of the position of the original corner.

C. Description of monument for corner and accessories established to perpetuate locating the position of the corner:

A-11 Set Monument and Remonumentation Cap.
N 60° E 10.46' Set 60d Nail & Remonumentation Disc in Southeast face of 16" Cherry.
S 40° E 13.67' Set 60d Nail & Remonumentation Disc in West face of 8" Ash.
S 20° W 5.49' Set 60d Nail & Remonumentation Disc in East face of 6" Hickory.
N 85° W 28.44' Set 60d Nail & Remonumentation Disc in South face of 18" Oak.
South 135.96' Found 1/2" Iron Rod Northeast Corner of Section 36, Rose Township.

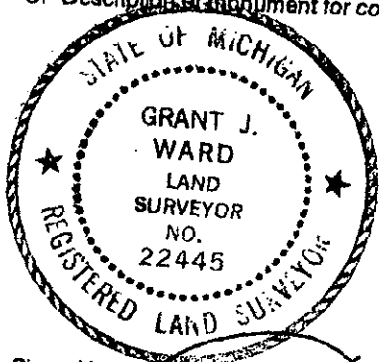

Signed by

Surveyor's Michigan License No. 22445

Date January 29, 1999

	A	B	C	D	E	F	G	H	I	J	K	L	M
2	6		5		4		3		2		1		
3													
4	7		8		9		10		11		12		
5													
6	18		17		16		15		14		13		
7													
8	19		20		21		22		23		24		
9													
10	30		29		28		27		26		25		
11													
12	31		32		33		34		35		36		
13													