

MAY 24 2000

LIBER 19832 PG 741

SECTION

LAND CORNER RECORDATION CERTIFICATE 128314  
Filing Requirement of Act 74, Mich. P.A. 1970

For corners in

Oakland

(County)

Located In:

Corner Code #

1. Public Land Survey

T	4N	R	8E	C-9
T		R		
T		R		
T		R		
T		R		
S		T	R	
S		T	R	
S		T	R	
S		T	R	

2. Property Controlling in Section

3. Miscellaneous Property in Sec.

4. Lot No. \_\_\_\_\_, Recorded Plat \_\_\_\_\_  
5. Private Claims \_\_\_\_\_

I, Grant J. Ward, R.L.S., in a field survey on February 9, 1998 do hereby state that under requirements of P.A. 74, Michigan P.A. of 1970, the corner points mentioned in lines 1 and 2 above were in conformance with regulations and rules therefore as required in the current manual of survey instructions of the United States Department of the Interior, Bureau of Land Management or by a decree of a Court of Law and for that the corner points mentioned in lines 3, 4 and 5 above were in conformance with the rules of the Michigan Board of Land Surveyors or by a Decree of a Court of Law; established, re-established, monumented, recovered, found as expressed below:

NOTE: Not more than 2 corners, all in the same town and range, may be recorded on this certificate.

A. Description of original monument and accessories and/or subsequent restoration:

C-9 Post, per G.L.O. Notes.

B. Description of corner evidence found and/or method applied in restoring or reestablishing corner:

C-9 Southwest Corner of Section 20, T. 4 N., R. 8 E. Found Stone Post.


Previously Recorded in L. 8801 P. 88 (4) of Oakland County Records.

(n) Indicates the number of references that confirms this corner by dimensional tie.

This corner location is a careful and faithful perpetuation of the position of the original corner.

C. Description of monument for corner and accessories established to perpetuate locating the position of the corner:

- C-9 Set Monument and Brass Remonumentation Cap.
- N 60° E 17.72' Set MAG Nail & Remonumentation Disc in South face of 6" Elm.
- S 70° E 21.29' Set MAG Nail & Remonumentation Disc in South face of 14" Oak.
- S 25° E 28.90' Set MAG Nail & Remonumentation Disc in East face of 18" Oak.
- N 15° W 20.10' Set MAG Nail & Remonumentation Disc in Southwest face of 12" Cherry.
- N 70° E 2.91' Found Monument.

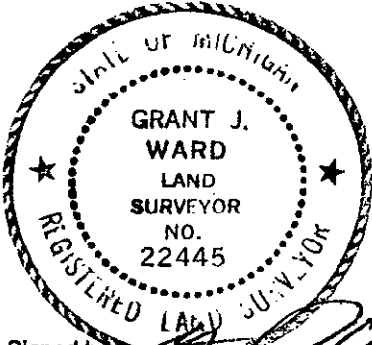

Signed by \_\_\_\_\_  
Surveyor's Michigan License No. 22445

Date February 9, 1999

LIBER 19832 PAGE 741  
\$9.00 MISC RECORDING  
\$2.00 REMONUMENTATION  
04/14/1999 01:54:01 P.M. RECEIPT# 18962  
PAID RECORDED - OAKLAND COUNTY  
G. WILLIAM CADDELL, CLERK/REGISTER OF DEEDS

Compliance with  
ACT 345, P.A. 1990

APPROVED ON: 2-10-99 JS  
OAKLAND COUNTY REMONUMENTATION  
PEER GROUP COMMITTEE

Register of Deeds Stamp & File Number

A	B	C	D	E	F	G	H	I	J	K	L	M
1												
2	6		5		4		3		2		1	
3												
4	7		8		9		10		11		12	
5												
6	18		17		16		15		14		13	
7												
8	19		20		21		22		23		24	
9												
10	30		29		28		27		26		25	
11												
12	31		32		33		34		35		36	

2p  
R