

MAY 24 2000

LIBER 19832PG735

SECTION

LAND CORNER RECORDATION CERTIFICATE
Filing Requirement of Act 74, Mich. P.A. 1970

128311

For corners in

| | | |
|------------------------------------|-------------|---------------|
| Oakland (County) | Located in: | Corner Code # |
| 1. Public Land Survey | T 4N R 8E | D-11 |
| | T R | |
| | T R | |
| | T R | |
| 2. Property Controlling in Section | S T R | |
| | S T R | |
| 3. Miscellaneous Property in Sec. | S T R | |
| | S T R | |

LIBER 19832 PAGE 735
 \$9.00 MISC RECORDING
 \$2.00 REMONUMENTATION
 04/14/1999 01:54:01 P.M. RECEIPT# 18962
 PAID RECORDED - OAKLAND COUNTY
 G. WILLIAM CADDELL, CLERK/REGISTER OF DEED

Compliance with
 ACT 345, P.A. 1990

APPROVED ON: 2-10-99 JS
 OAKLAND COUNTY REMONUMENTATION
 PEER GROUP COMMITTEE
 Register of Deeds Stamp & File Number

4. Lot No. _____, Recorded Plat _____
 5. Private Claims _____

I, Grant J. Ward, R.L.S., in a field survey on March 4, 1998 do hereby state that under requirements of P.A. 74, Michigan P.A. of 1970, the corner points mentioned in lines 1 and 2 above were in conformance with regulations and rules therefore as required in the current manual of survey instructions of the United States Department of the Interior, Bureau of Land Management or by a decree of a Court of Law and /or that the corner points mentioned in lines 3, 4 and 5 above were in conformance with the rules of the Michigan Board of Land Surveyors or by a Decree of a Court of Law; established, re-established, monumented, recovered, found as expressed below:

| A | B | C | D | E | F | G | H | I | J | K | L | M |
|----|----|----|----|----|----|----|---|---|---|---|---|---|
| 1 | | | | | | | | | | | | |
| 2 | 6 | 5 | 4 | 3 | 2 | 1 | | | | | | |
| 3 | | | | | | | | | | | | |
| 4 | 7 | 8 | 9 | 10 | 11 | 12 | | | | | | |
| 5 | | | | | | | | | | | | |
| 6 | 18 | 17 | 16 | 15 | 14 | 13 | | | | | | |
| 7 | | | | | | | | | | | | |
| 8 | 19 | 20 | 21 | 22 | 23 | 24 | | | | | | |
| 9 | | | | | | | | | | | | |
| 10 | 30 | 29 | 28 | 27 | 26 | 25 | | | | | | |
| 11 | | | | | | | | | | | | |
| 12 | 31 | 32 | 33 | 34 | 35 | 36 | | | | | | |
| 13 | | | | | | | | | | | | |

NOTE: Not more than 2 corners, all in the same town and range, may be recorded on this certificate.

A. Description of original monument and accessories and/or subsequent restoration:

D-11 Post, per G.L.O. Notes.

Handwritten initials

B. Description of corner evidence found and/or method applied in restoring or reestablishing corner:


D-11 North 1/4 corner of Section 32, T. 4 N., R. 8 E. Found 3/4" Iron Pipe in Centerline of Shaffer Road.
 Previously Recorded in L. 6048 P. 647 (4), L. 6961 P. 104 (2), 11225 P. 577 (4) and L. 12060 P. 457 (4) of Oakland County Records.

(n) Indicates the number of references that confirms this corner by dimensional tie.

This corner location is accepted by the contractor and is generally accepted by professional surveyors as the best available evidence of the position of the original corner.

C. Description of monument for corner and accessories established to perpetuate locating the position of the corner:

- D-11 Set 5/8" Iron Rod and Remonumentation Cap.
- S 30° E 18.32' Set MAG Nail & Remonumentation Disc in Northeast face of 6" Walnut.
- S 60° W 30.10' Set MAG Nail & Remonumentation Disc in Northwest face of 6" Walnut.
- N 50° W 39.63' Set MAG Nail & Remonumentation Disc in East face of 18" Oak.
- N 05° W 21.04' Set MAG Nail & Remonumentation Disc in Southwest face of 24" Oak.

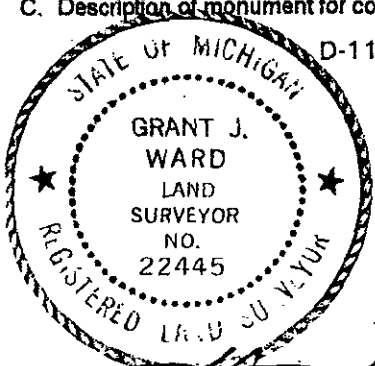

Signed by _____
 Surveyor's Michigan License No. 22445

Date January 29, 1999