

LAND CORNER RECORDATION CERTIFICATE
Filing Requirement of Act 74, Mich. P.A. 1970

\$ 7.00 MISCELLANEOUS RECORDING
\$ 2.00 REMONUMENTATION
2 OCT 98 8:44 A.M. RECEIPT PAID
RECORDED - OAKLAND COUNTY
LYNN D. ALLEN, CLERK/REGISTER OF DEEDS

10098290119

For corners in

Oakland
(county)

Located In: Corner Code #

- 1. Public Land Survey T 4N R 8E D-13
T ___ R ___
T ___ R ___
T ___ R ___
- 2. Property Controlling S ___ T ___ R ___
in Section S ___ T ___ R ___
3. Miscellaneous S ___ T ___ R ___
Property in Sec. S ___ T ___ R ___

Compliance with
ACT 345, P.A. 1990
APPROVED ON: 11-8-98 JS
OAKLAND COUNTY REMONUMENTATION
PEER GROUP COMMITTEE
Register of Deeds Stamp & File Number

4. Lot No. _____, Recorded Plat _____ SECTION _____

5. Private Claims _____

I, James E. Kovas, in a field survey on September 16, 1997, do hereby certify that under requirements of P.A. 74, Michigan P.A. of 1970, the corner points mentioned in lines 1 and 2 above were in conformance with regulations and rules therefore as required in the current manual of survey instructions of the United States Department of the Interior, Bureau of Land Management or by a decree of a Court of Law and/or that the corner points mentioned in lines 3, 4 and 5 above were in conformance with the rules of the Michigan Board of Land Surveyors or by a Decree of a Court of Law; established, re-established, monumented, re-monumented, recovered, found as expressed below:


A	B	C	D	E	F	G	H	I	J	K	L	M
2	6	5	4	3	2	1						
3												
4	7	8	9	10	11	12						
5												
6	13	17	16	15	14	13						
7												
8	19	20	21	22	23	24						
9												
10	30	29	28	27	26	25						
11												
12	31	32	33	34	35	36						
13												

NOTE: Not more than 4 corners, all in the same town and range, may be recorded on this certificate.

A. Description of original monument and accessories and/or subsequent restoration:
D-13

- 1815- Government Land Office (G.L.O.) Alex Holmes, D.S., set post
- 1950- Survey of Part N1/2 of Sec. 5 for Bernard Orchard Company, no monument described
- 1977- John Albright #10057 (LCRC Liber 7077 Page 262), found 1/2" rerod
- 1980- Norman Fahrner #17620 (LCRC Liber 8000 Page 818), set 1/2" iron pipe at location of evidence of old corner which was lost
- 1981- Norman Fahrner #17620 (Washtenaw Engineering), (Unrecorded survey), set 1/2" iron pipe
- 1988- Cornerstone Gil Bonno #32332 (Unrecorded survey), found 3/4" pipe

- Distances:
- D-13 to E-13 = 2662.68' (Wade-Trim - 1997)
 - D-13 to C-13 = 2665.21' (Wade-Trim - 1997)
 - D-13 to D-1 (Springfield) = 112.06' east (Washtenaw Eng. - 1981)
112.25' east (Wade-Trim - 1997)

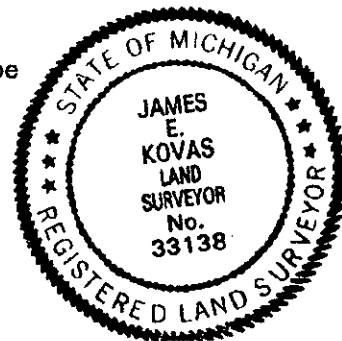

B. Description of corner evidence found and/or method applied in restoring or reestablishing corner:

D-13 Found 3/4" pipe with cap #17620

WITNESSES FOUND:	Easterly 21.86'	to nail in 2" Hickory	no nail in tree	Found 21.5' +/-
	N 45 W 0.46'	to nail in 6" Oak	no nail in tree	Found 0.5' +/-
	Westerly 10.65'	to nail in 4" multiple Cherry		Found 10.45'
	N 10 E 29.83'	to nail in 6" Cherry		Found 30.1'
	West 10.38'	nail/tag 32332 in 12" Cherry		Found 10.4'
	East 21.88'	nail/tag 32332 in 6" Hickory		Found 22.2'
	North 0.66'	nail/tag 32332 in 8" Oak		Found 0.6'

C. Description of monument for corner and accessories established to perpetuate locating the position of the corner:

D-13 Note: Cannot set conc. Mon., pipe is only 0.1 off Oak. Oak is probably pushing pipe to the south.
Note: Set 1/2" rerod w/ remon cap inside pipe.

- WIT: West 10.88' Set remon tag in South face triple (was a quad, one stem died) White Cherry
East 21.98' Set remon tag in South face 8" Hickory
N 78 E 18.64' Set remon tag in South face 8" Fruit Tree
East 112.25' to D-1, the North 1/4 corner Section 5, T3N, R8E (Remon Cap on 5/8" iron)

700 file
200

Signed by James E. Kovas Date 9/10/98

Surveyor's Michigan License No. 33138