

MAY 24 2000

118FR19237PC882

DE-4 98 3 4 7 6 3 8

SECTION

LAND CORNER RECORDATION CERTIFICATE  
Filing Requirement of Act 74, Mich. P.A. 1970

\$ 9.00 MISCELLANEOUS RECORDING  
\$ 2.00 REMONUMENTATION  
4 DEC 98 8:33 A.M. RECEIPT# 48  
PAID RECORDED - OAKLAND COUNTY  
G. WILLIAM CARDELL  
CLERK/REGISTER OF DEEDS

For corners in

Oakland	Located In:	Corner Code #
(County)		
1. Public Land Survey	T 4NR 8E	E-1
	T R	
	T R	
	T R	
2. Property Controlling in Section	S T R	
	S T R	
3. Miscellaneous Property in Sec.	S T R	
	S T R	
4. Lot No. _____, Recorded Plat _____		
5. Private Claims _____		

Compliance with ACT 345, P.A. 1990  
APPROVED ON: 9-28-98 JS  
OAKLAND COUNTY REMONUMENTATION PEER GROUP COMMITTEE

Register of Deeds Stamp & File Number

I, Grant J. Ward, R.L.S., in a field survey on October 20, 1997 do hereby state that under requirements of P.A. 74, Michigan P.A. of 1970, the corner points mentioned in lines 1 and 2 above were in conformance with regulations and rules therefore as required in the current manual of survey instructions of the United States Department of the Interior, Bureau of Land Management or by a decree of a Court of Law and/or that the corner points mentioned in lines 3, 4 and 5 above were in conformance with the rules of the Michigan Board of Land Surveyors or by a Decree of a Court of Law; established, re-established, monumented, recovered, found as expressed below:

NOTE: Not more than 2 corners, all in the same town and range, may be recorded on this certificate.

	A	B	C	D	E	F	G	H	I	J	K	L	M
1													
2	6		5		4		3		2		1		
3													
4	7		8		9		10		11		12		
5													
6	10		17		16		15		14		13		
7													
8	19		20		21		22		23		24		
9													
10	30		29		28		27		26		25		
11													
12	31		32		33		34		35		36		
13													

A. Description of original monument and accessories and/or subsequent restoration:

E-1 Post, per G.L.O. Notes.

B. Description of corner evidence found and/or method applied in restoring or reestablishing corner:

E-1 Northeast Corner of Section 5, T. 4 N., R. 8 E. Found 1/2" Iron Rod & Cap 9' +/- East of Centerline of Tindall Road.


Previously Recorded in L. 13162 P. 799 (4) of Oakland County Records.

(n) Indicates the number of references that confirms this corner by dimensional tie.

This corner location is accepted by the contractor and is generally accepted by professional surveyors as the best available evidence of the position of the original corner.

C. Description of monument for corner and accessories established to perpetuate locating the position of the corner:

- E-1 Set 5/8" Iron Rod and Remonumentation Cap.
- N 65° E 74.35' Set MAG Nail & Remonumentation Disc in South face of 4" Austrian Pine.
- S 80° E 72.91' Set MAG Nail & Remonumentation Disc in Northeast face of 4" Austrian Pine.
- S 45° E 99.67' Set MAG Nail & Remonumentation Disc in North face of 4" Austrian Pine.
- S 70° W 87.52' Set MAG Nail & Remonumentation Disc in Southeast face of 2" Spruce.
- West 5.26' Found 1/2" Iron Rod Southeast Corner of Section 32, T. 5 N., R. 8 E., Groveland Township.

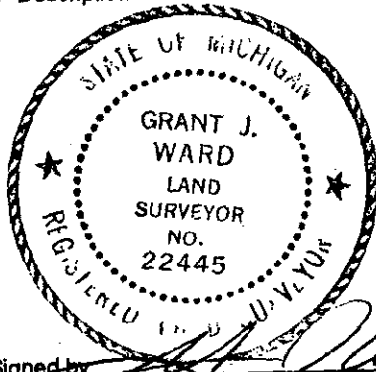

Signed by \_\_\_\_\_  
Surveyor's Michigan License No. 22445

Date February 17, 1998

9-28-98 JS