

MAR 11 1999

SECTION

LIBER 19237PG892

LAND CORNER RECORDATION CERTIFICATE  
Filing Requirement of Act 74, Mich. P.A. 1970

For corners in

Oakland (County)	Located In:	Corner Code #
1. Public Land Survey	T 4NR 8E	E-6
	T R	
	T R	
	T R	
2. Property Controlling in Section	S T R	
	S T R	
3. Miscellaneous Property in Sec.	S T R	
	S T R	

\$ 9.00 MISCELLANEOUS RECORDING  
 \$ 2.00 REMONUMENTATION  
 4 DEC 98 8:33 A.M. RECEIPT # 983  
 PAID RECORDED - OAKLAND COUNTY  
 G. WILLIAM CADDELL  
 CLERK/REGISTER OF DEEDS

Compliance with ACT 345, P.A. 1990

APPROVED ON: 2-04-98 JS  
 OAKLAND COUNTY REMONUMENTATION  
 PEER GROUP COMMITTEE

Register of Deeds Stamp & File Number

4. Lot No. \_\_\_\_\_, Recorded Plat \_\_\_\_\_  
 5. Private Claims \_\_\_\_\_

I, Grant J. Ward, R.L.S., in a field survey on December 31, 1997 do hereby state that under requirements of P.A. 74, Michigan P.A. of 1970, the corner points mentioned in lines 1 and 2 above were in conformance with regulations and rules therefore as required in the current manual of survey instructions of the United States Department of the Interior, Bureau of Land Management or by a decree of a Court of Law and/or that the corner points mentioned in lines 3, 4 and 5 above were in conformance with the rules of the Michigan Board of Land Surveyors or by a Decree of a Court of Law; established, re-established, monumented, recovered, found as expressed below:

NOTE: Not more than 2 corners, all in the same town and range, may be recorded on this certificate.

	A	B	C	D	E	F	G	H	I	J	K	L	M
1													
2	6		5		4		3		2		1		
3													
4	7		8		9		10		11		12		
5													
6	18		17		16		15		14		13		
7													
8	19		20		21		22		23		24		
9													
10	30		29		28		27		26		25		
11													
12	31		32		33		34		35		36		
13													

A. Description of original monument and accessories and/or subsequent restoration:

E-6 Post, per G.L.O. Notes.

B. Description of corner evidence found and/or method applied in restoring or reestablishing corner:


E-6 West 1/4 Corner of Section 16, T. 4 N., R. 8 E. Found 1/2" Iron Rod with Cap "WARD" 9' +/- East of Centerline of Dilley Road.

Previously Recorded in L. 6194 P. 351 (2) and L. 9912 P. 534 (4) of Oakland County Records.

(n) Indicates the number of references that confirms this corner by dimensional tie.

This corner location is accepted by the contractor and is generally accepted by professional surveyors as the best available evidence of the position of the original corner.

C. Description of monument for corner and accessories established to perpetuate locating the position of the corner:

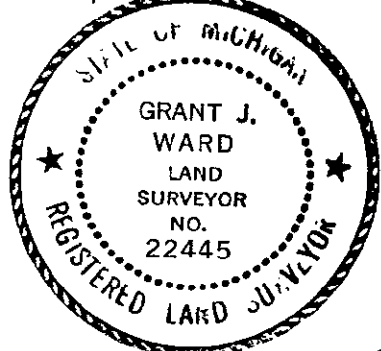

- E-6 Set 5/8" Iron Rod and Remonumentation Cap.
- East 35.18' Set MAG Nail & Remonumentation Disc in South face of 6" Poplar.
- S 10° E 61.65' Set MAG Nail & Remonumentation Disc in West face of 4" Dogwood.
- S 50° W 38.34' Set MAG Nail & Remonumentation Disc in Southeast face of 8" Boxelder.
- N 15° W 101.85' Scratched "X" on Top of Metal Corner Post.

Signed by \_\_\_\_\_  
 Surveyor's Michigan License No. 22445

Date January 30, 1998

500 FILE  
200

MAR 11 1999

LIBER 19237PG893

SECTION

FEBRUARY 1, 1998

Corner Code: E-6

DOSSIER FOR: THE WEST 1/4 CORNER OF SECTION 16, SPRINGFIELD TOWNSHIP, T 4 N, R 8 E, OAKLAND COUNTY, MICHIGAN. Prepared under contract with the County of Oakland Under Act 345 of the Public Acts of 1990.

HISTORY:

The boundary of this Township was surveyed by Alex Holmes, D.S. in 1815 and Joseph Wampler, D.S. set the Corners for the subdivision of it in 1823.

SPECIAL NOTES:

This Corner has been accepted and used since before 1973, as evidenced by the Corner being recorded under Act 74 of the Public Acts of 1970, by Forrest R. Jones, R.L.S. as recorded in Liber 6194, Page 351.

COLLATERAL EVIDENCE:

This Corner lies 9 feet East of the Centerline of Dilley Road and 33 feet East of a fence line running North and South and 142 feet South of the Centerline of the railroad tracks. There is a U.S.G.S. monument N. 01° 47' 20" E. 202.01 feet from the Corner.

We searched at least 50 feet in each direction for other stakes and found none that might represent the Corner.

The measured dimensions to the Southwest Corner of Section 16 agree with the recorded distances within 0.2 feet.

SURVEYOR'S RECOMMENDATIONS:

The selected location is accepted by the Contractor and is generally accepted by Professional Surveyors as the best available evidence of the position of the original Corner. Therefore, I recommend that the Peer Review Group accept this Corner as monumented, with the references as shown on the enclosed form prepared according to Act 74 of the Public Acts of 1970, while considering the other iron we found near the Corner.

---

Grant J. Ward, R.L.S.  
License No. 22445

RECORDED