

SURVEY & REMONUMENTATION

MAY 24 2000

LIBR 19237PG894

15-498347644

SECTION

LAND CORNER RECORDATION CERTIFICATE

Filing Requirement of Act 74, Mich. P.A. 1970 \$ 9.00 MISCELLANEOUS RECORDING

For corners in

Oakland	Located in:	Corner Code #
(County)		
1. Public Land Survey	T 4NR 8E	E-7
	T R	
	T R	
	T R	
2. Property Controlling in Section	S T R	
	S T R	
3. Miscellaneous Property in Sec.	S T R	
	S T R	

\$ 2.00 REMONUMENTATION
 4 DEC 98 8:34 A.M. RECEIPT 48
 PAID RECORDED - OAKLAND COUNTY
 G. WILLIAM CAIDELL
 CLERK/REGISTER OF DEEDS

Compliance with
 ACT 345, P.A. 1990

APPROVED ON: 1-08-98 JS
 OAKLAND COUNTY REMONUMENTATION
 PEER GROUP COMMITTEE

Register of Deeds Stamp & File Number

4. Lot No. _____, Recorded Plat _____
 5. Private Claims _____

Grant J. Ward, R.L.S., in a field survey on January 16th 98 do hereby state that under requirements of P.A. 74, Michigan P.A. of 1970, the corner points mentioned in lines 1 and 2 above were in conformance with regulations and rules therefore as required in the current manual of survey instructions of the United States Department of the Interior, Bureau of Land Management or by a decree of a Court of Law and /or hat the corner points mentioned in lines 3, 4 and 5 above were in conformance with the rules of the Michigan Board of Land Surveyors or by a Decree of a Court of Law; established, re-established, monumented, recovered, found as expressed below:

NOTE: Not more than 2 corners, all in the same town and range, may be recorded on this certificate.

A	B	C	D	E	F	G	H	I	J	K	L	M
2	6	5	4	3	2	1						
3												
4	7	8	9	10	11	12						
5												
6	10	17	16	15	14	13						
7												
8	19	20	21	22	23	24						
9												
10	30	29	28	27	26	25						
11												
12	31	32	33	34	35	36						
13												

A. Description of original monument and accessories and/or subsequent restoration:

E-7 Post, per G.L.O. Notes.

3. Description of corner evidence found and/or method applied in restoring or reestablishing corner:

E-7 Southwest Corner of Section 16, T. 4 N., R. 8 E. Found 1/2" Iron Rod 3' +/- South of Centerline of Clark Road and 5' +/- East of Centerline of Dilley Road.


Previously Recorded in L. 6347 P. 173 (3), L. 7037 P. 887 (3), L. 7177 P. 612 (2), L. 7455 P. 858 (4) and L. 9912 P. 534 (5) of Oakland County Records.

(n) Indicates the number of references that confirms this corner by dimensional tie.

This corner location is accepted by the contractor and is generally accepted by professional surveyors as the best available evidence of the position of the original corner.

2. Description of monument for corner and accessories established to perpetuate locating the position of the corner:

- E-7 Set 5/8" Iron Road and Remonumentation Cap.
- N 70° E 54.41' Set MAG Nail & Remonumentation Disc in South face of 12" Oak.
- S 20° E 19.93' Set MAG Nail & Remonumentation Disc in West face of 30" Oak.
- West 90.76' Set MAG Nail & Remonumentation Disc in North face of 28" Oak.
- N 20° W 63.70' Set MAG Nail & Remonumentation Disc in East face of Power Pole.
- South 32.96' Found "T" Iron

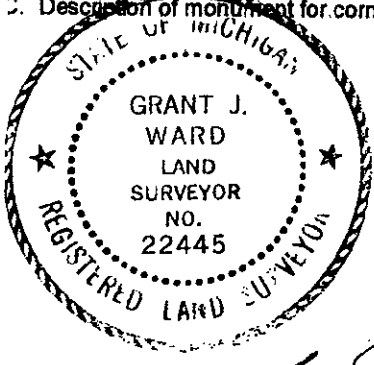

Signed by _____
 Surveyor's Michigan License No. 22445

Date January 30, 1998

G.W. FILE
2