

LAND CORNER RECORDATION CERTIFICATE  
Filing Requirement of Act 74, Mich. P.A. 1970 **128302**

For corners in

Oakland  
(County)

Located In: Corner Code #

1. Public Land Survey

T 4N R 8E E-9

2. Property Controlling  
in Section

S T R SURVEY & RE-MONUMENTATION

3. Miscellaneous  
Property in Sec.

S T R MAR 21 2000

SECTION

4. Lot No. \_\_\_\_\_, Recorded Plat \_\_\_\_\_  
5. Private Claims \_\_\_\_\_

LIBER 19832 PAGE 720  
\$7.00 MISC RECORDING  
\$2.00 REMONUMENTATION  
04/14/1999 01:53:27 P.M. RECEIPT# 18962  
PAID RECORDED - OAKLAND COUNTY  
G. WILLIAM CADDELL, CLERK/REGISTER OF DEEDS

Compliance with  
ACT 345, P.A. 1990

APPROVED ON: 2-10-99 JS  
OAKLAND COUNTY REMONUMENTATION  
PEER GROUP COMMITTEE

Register of Deeds Stamp & File Number

I, Grant J. Ward, R.L.S., in a field survey on February 6, 1998 do hereby state that under requirements of P.A. 74, Michigan P.A. of 1970, the corner points mentioned in lines 1 and 2 above were in conformance with regulations and rules therefore as required in the current manual of survey instructions of the United States Department of the Interior, Bureau of Land Management or by a decree of a Court of Law and/or that the corner points mentioned in lines 3, 4 and 5 above were in conformance with the rules of the Michigan Board of Land Surveyors or by a Decree of a Court of Law, established, re-established, monumented, recovered, found as expressed below:

NOTE: Not more than 2 corners, all in the same town and range, may be recorded on this certificate.

	A	B	C	D	E	F	G	H	I	J	K	L	M
1													
2	6		5		4		3		2		1		
3													
4	7		8		9		10		11		12		
5													
6	18		17		16		15		14		13		
7													
8	19		20		21		22		23		24		
9													
10	30		29		28		27		26		25		
11													
12	31		32		33		34		35		36		
13													

A. Description of original monument and accessories and/or subsequent restoration:

E-9 Post, per G.L.O. Notes.

B. Description of corner evidence found and/or method applied in restoring or reestablishing corner:

E-9 Southeast Corner of Section 20, T. 4 N., R. 8 E. Found 1" Iron Pipe.

Previously Recorded in L. 6048 P. 653 (2) and L. 14590 P. 789 (4) of Oakland County Records.


(n) Indicates the number of references that confirms this corner by dimensional tie.

This corner location is accepted by the contractor and is generally accepted by professional surveyors as the best available evidence of the position of the original corner.

C. Description of monument for corner and accessories established to perpetuate locating the position of the corner:

E-9 Set Monument and Remonumentation Cap.

- N 85° E 12.59' Set MAG Nail & Remonumentation Disc in South face of 6" Tamarack (Dead).
- S 40° W 18.62' Set MAG Nail & Remonumentation Disc in East face of 4" Tamarack (Dead).
- S 80° W 34.49' Set MAG Nail & Remonumentation Disc in South face of 4" Tamarack (Dead).
- N 50° W 25.43' Set MAG Nail & Remonumentation Disc in Southwest face of 4" Tamarack (Dead).

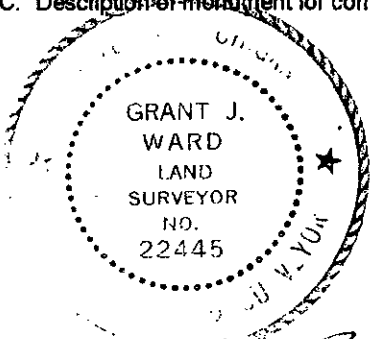

Signed by [Signature]  
Surveyor's Michigan License No. 22445

Date February 9, 1999

# 328 02