

MAY 24 2000

LIBER 19832PG729

LAND CORNER RECORDATION CERTIFICATE
Filing Requirement of Act 74, Mich. P.A. 1970

128308

For corners in

Oakland

(County)

Located in:

Corner Code #

1. Public Land Survey

	T	4N	R	8E	E-12
	T		R		
	T		R		
	T		R		
	S		T		
	S		T		
	S		T		
	S		T		

2. Property Controlling in Section

3. Miscellaneous Property in Sec.

4. Lot No. _____, Recorded Plat _____

5. Private Claims _____

LIBER 19832 PAGE 729
\$9.00 MISC RECORDING
\$2.00 REMONUMENTATION
04/14/1999 01:54:01 P.M. RECEIPT# 18962
PAID RECORDED - OAKLAND COUNTY
G. WILLIAM CADDELL, CLERK/REGISTER OF DEED

Compliance with
ACT 345, P.A. 1990

APPROVED ON: 2-10-99 JS
OAKLAND COUNTY REMONUMENTATION
PEER GROUP COMMITTEE

Register of Deeds Stamp & File Number

I, Grant J. Ward, R.L.S., in a field survey on April 23, 1998 do hereby state that under requirements of P.A. 74, Michigan P.A. of 1970, the corner points mentioned in lines 1 and 2 above were in conformance with regulations and rules therefore as required in the current manual of survey instructions of the United States Department of the Interior, Bureau of Land Management or by a decree of a Court of Law and for that the corner points mentioned in lines 3, 4 and 5 above were in conformance with the rules of the Michigan Board of Land Surveyors or by a Decree of a Court of Law, established, re-established, monumented, recovered, found as expressed below:

NOTE: Not more than 2 corners, all in the same town and range, may be recorded on this certificate.

	A	B	C	D	E	F	G	H	I	J	K	L	M
1													
2	6		5		4		3		2		1		
3													
4	7		8		9		10		11		12		
5													
6	18		17		16		15		14		13		
7													
8	19		20		21		22		23		24		
9													
10	30		29		28		27		26		25		
11													
12	31		32		33		34		35		36		
13													

A. Description of original monument and accessories and/or subsequent restoration:

E-12 Post, per G.L.O. Notes.

B. Description of corner evidence found and/or method applied in restoring or reestablishing corner:

E-12 West 1/4 Corner of Section 33, T. 4 N., R. 8 E. Found 1 - 1/2" Iron Pipe.


Previously Recorded in L. 6048 P. 659 (3) and L. 8000 P. 816 of Oakland County Records.

(n) Indicates the number of references that confirms this corner by dimensional tie.

This corner location is accepted by the contractor and is generally accepted by professional surveyors as the best available evidence of the position of the original corner.

C. Description of monument for corner and accessories established to perpetuate locating the position of the corner:

- E-12 Set Monument and Remonumentation Cap.
- S 80° E 11.35' Set MAG Nail & Remonumentation Disc in North face of Twin 22"-12" Oaks.
- S 30° E 28.19' Set MAG Nail & Remonumentation Disc in Southwest face of 20" Oak.
- S 10° W 8.54' Set MAG Nail & Remonumentation Disc in Northwest face of 24" Oak.
- N 40° W 20.65' Set MAG Nail & Remonumentation Disc in Southwest face of 10" Oak.

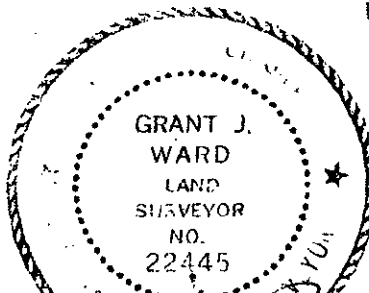

Signed by _____
Surveyor's Michigan License No. 22445

Date February 9, 1999