

MAY 24 2000

SECTION

18FR19237PG698

LAND CORNER RECORDATION CERTIFICATE
Filing Requirement of Act 74, Mich. P.A. 1970

For corners in

Oakland (County)	Located In:	Corner Code #
1. Public Land Survey	T 4N R 8E	F-1
	T R	
	T R	
	T R	
2. Property Controlling in Section	S T R	
	S T R	
3. Miscellaneous Property in Sec.	S T R	
	S T R	

\$ 9.00 MISCELLANEOUS RECORDING

\$ 2.00 REMONUMENTATION

4 DEC 98 8:34 A.M. RECEIPT 48
PAID RECORDED - OAKLAND COUNTY
G. WILLIAM CADDELL
CLERK/REGISTER OF DEEDS

Compliance with
ACT 345, P.A. 1990
APPROVED ON: 4-08-98 JS
OAKLAND COUNTY REMONUMENTATION
PEER GROUP COMMITTEE

Register of Deeds Stamp & File Number

- 4. Lot No. _____, Recorded Plat _____
- 5. Private Claims _____

I, Grant J. Ward, R.L.S., in a field survey on March 10, 1998 do hereby state that under requirements of P.A. 74, Michigan P.A. of 1970, the corner points mentioned in lines 1 and 2 above were in conformance with regulations and rules therefore as required in the current manual of survey instructions of the United States Department of the Interior, Bureau of Land Management or by a decree of a Court of Law and /or that the corner points mentioned in lines 3, 4 and 5 above were in conformance with the rules of the Michigan Board of Land Surveyors or by a Decree of a Court of Law; established, re-established, monumented, recovered, found as expressed below:

NOTE: Not more than 2 corners, all in the same town and range, may be recorded on this certificate.

A	B	C	D	E	F	G	H	I	J	K	L	M
1												
2	6		5		4		3		2		1	
3												
4	7		8		9		10		11		12	
5												
6	10		17		16		15		14		13	
7												
8	19		20		21		22		23		24	
9												
10	30		29		28		27		26		25	
11												
12	31		32		33		34		35		36	
13												


A. Description of original monument and accessories and/or subsequent restoration:
F-1 Post, per G.L.O. Notes.

B. Description of corner evidence found and/or method applied in restoring or reestablishing corner:
F-1 North 1/4 Corner of Section 4, T. 4 N., R. 8 E. Nothing Found.

Previously unrecorded.

This corner location, although not established by an original government survey, is accepted by the contractor and is generally accepted by professional surveyors as the best available evidence of the position of the original corner.

C. Description of monument for corner and accessories established to perpetuate locating the position of the corner:

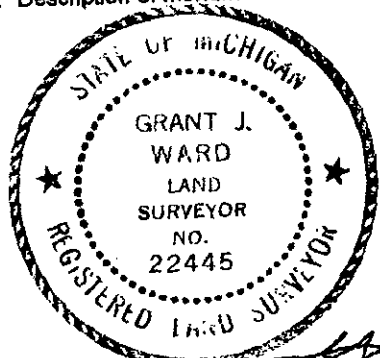

- F-1 Set Monument and Remonumentation Cap.
- N 30° E 16.56' Set MAG Nail & Remonumentation Disc in Timber Wall.
- N 80° E 67.75' Set MAG Nail & Remonumentation Disc in South face of 6" Cherry.
- East 28.74' Set MAG Nail & Remonumentation Disc in Top of 18" Stump.
- S 55° W 24.19' Corner Post of Fence
- West 14.56' Found 1/2" Iron Pipe (F-13 Groveland Twp.)

Signed by _____
Surveyor's Michigan License No. 22445

Date March 11, 1998

498347646

900 FILE
200