

MAR 11 1999

LIBER 192381001

DE-498347618

SECTION

LAND CORNER RECORDATION CERTIFICATE
Filing Requirement of Act 74, Mich. P.A. 1970

\$ 9.00 MISCELLANEOUS RECORDING
\$ 2.00 REMONUMENTATION
4 DEC 98 8:34 A.M. RECEIPT # 48
PAID RECORDED - OAKLAND COUNTY
G. WILLIAM CADDELL
CLERK/REGISTER OF DEEDS

For corners in

Oakland (County)	Located In:	Corner Code #
1. Public Land Survey	T 4N R 8E	F-5
	T R	
	T R	
	T R	
2. Property Controlling in Section	S T R	
	S T R	
3. Miscellaneous Property in Sec.	S T R	
	S T R	

Compliance with ACT 345, P.A. 1990

APPROVED ON: 1-20-98 J
OAKLAND COUNTY REMONUMENTATION PEER GROUP COMMITTEE

Register of Deeds Stamp & File Number

- 4. Lot No. _____, Recorded Plat _____
- 5. Private Claims _____

I, Grant J. Ward, R.L.S., in a field survey on December 2, 1997 do hereby state that under requirements of P.A. 74, Michigan P.A. of 1970, the corner points mentioned in lines 1 and 2 above were in conformance with regulations and rules therefore as required in the current manual of survey instructions of the United States Department of the Interior, Bureau of Land Management or by a decree of a Court of Law and/or that the corner points mentioned in lines 3, 4 and 5 above were in conformance with the rules of the Michigan Board of Land Surveyors or by a Decree of a Court of Law, established, re-established, monumented, recovered, found as expressed below.

NOTE: Not more than 2 corners, all in the same town and range, may be recorded on this certificate.

	A	B	C	D	E	F	G	H	I	J	K	L	M
1													
2	6		5		4		3		2		1		
3													
4	7		8		9		10		11		12		
5													
6	18		17		16		15		14		13		
7													
8	19		20		21		22		23		24		
9													
10	30		29		28		27		26		25		
11													
12	31		32		33		34		35		36		
13													

A. Description of original monument and accessories and/or subsequent restoration:

F-5 Post, per G.L.O. Notes.

B. Description of corner evidence found and/or method applied in restoring or reestablishing corner:

F-5 South 1/4 Corner of Section 9, T. 4 N., R. B E. Found 1/2" Rod in Swamp.


Previously Recorded in L. 5961 P. 585 (3), L. 7455, P. 857 (2) and L. 8096 P. 221 (3) of Oakland County Records.

(n) Indicates the number of references that confirms this corner by dimensional tie.

This corner location is accepted by the contractor and is generally accepted by professional surveyors as the best available evidence of the position of the original corner.

C. Description of monument for corner and accessories established to perpetuate locating the position of the corner:

- F-5 Set Monument and Brass Cap.
 - N 55° E 12.74' Set MAG Nail & Remonumentation Disc in Southeast face of 6" Elm.
 - N 75° E 38.66' Set MAG Nail & Remonumentation Disc in Southeast face of Triple 8" Oak.
 - N 85° E 49.90' Set MAG Nail & Remonumentation Disc in South face of 30" Oak.
 - N 45° W 14.36' Set MAG Nail & Remonumentation Disc in Southwest face of 8" Birch.

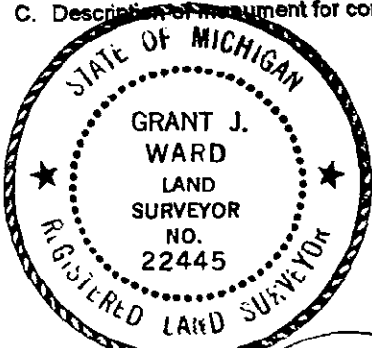

Signed by _____
Surveyor's Michigan License No. 22445

Date January 2, 1998

90 File
200

LIBER 192381001

MAR 11 1999

SECTION

JANUARY 8, 1998

Corner Code: F-5

DOSSIER FOR: THE SOUTH 1/4 CORNER OF SECTION 9, SPRINGFIELD TOWNSHIP, T 4 N, R 8 E, OAKLAND COUNTY, MICHIGAN. Prepared under contract with the County of Oakland Under Act 345 of the Public Acts of 1990.

HISTORY:

The boundary of this Township was surveyed by Alex Holmes, D.S. in 1815 and Joseph Wampler, D.S. set the Corners for the subdivision of it in 1823.

SPECIAL NOTES:

This Corner has been accepted and used since before 1972, as evidenced by a recording under Act 74 of the Public Acts of 1970 by James H. Buckerfield, Surveyor as recorded in Liber 5961, Page 585.

COLLATERAL EVIDENCE:

This Corner lies 60 feet West of and on line with an old laid down fence. There is a tree and rock row running North starting 200' +/- North of the Corner. The measured dimensions to the Southwest Corner and the Southeast Corner of Section 9 agree with the recorded dimensions within 1.5 feet and 0.5 feet respectively. We searched at least 50 feet in each direction for other stakes and found none that might represent the Corner.

SURVEYOR'S RECOMMENDATIONS:

The selected location is accepted by the Contractor and is generally accepted by Professional Surveyors as the best available evidence of the position of the original Corner. Therefore, I recommend that the Peer Review Group accept this Corner as monumented, with the references as shown on the enclosed form prepared according to Act 74 of the Public Acts of 1970.

Grant J. Ward, R.L.S.
License No. 22445