

LIBER 19012PC355

LAND CORNER RECORDATION CERTIFICATE
Filing Requirement of Act 74, Mich. P.A. 1970

For corners in

Oakland (county) Located In: Corner Code #

- 1. Public Land Survey T 4N R 8E F-13
2. Property Controlling in Section S T R SURVEY & RE-RECORDATION
3. Miscellaneous Property in Sec. S T R MAR 21 2000

\$ 7.00 MISCELLANEOUS RECORDING
\$ 2.00 REMONUMENTATION
2 OCT 98 8:45 A.M. RECEIPT PAID
RECORDED - OAKLAND COUNTY
LYNN D. ALLEN, CLERK/REGISTER OF DEEDS

Compliance with ACT 345, P.A. 1990

APPROVED ON: 11-8-98 JS
OAKLAND COUNTY REMONUMENTATION
Register of Deeds Stamp & Filing Number

4. Lot No. Recorded Plat SECTION

5. Private Claims

I, James E. Kovas in a field survey on August 19, 1997 do hereby certify that under requirements of P.A. 74, Michigan P.A. of 1970, the corner points mentioned in lines 1 and 2 above were in conformance with regulations and rules therefore as required in the current manual of survey instructions of the United States Department of the Interior, Bureau of Land Management or by a decree of a Court of Law and/or that the corner points mentioned in lines 3, 4 and 5 above were in conformance with the rules of the Michigan Board of Land Surveyors or by a Decree of a Court of Law; established, re-established, monumented, re-monumented, recovered, found as expressed below:


Grid table with columns A-K and rows 1-13. A dot is marked at the intersection of column G and row 12.

NOTE: Not more than 4 corners, all in the same town and range, may be recorded on this certificate.

A. Description of original monument and accessories and/or subsequent restoration:

- F-13
1823- Government Land Office (G.L.O) Wampler, D.S., quarter post set on township line
1890- County Surveyors Records(Unrecorded survey), no monument described
1970- Ray Kostecke (Unrecorded survey), no monument described
1973- Edward Anderson #11495 (LCRC Liber 6252 Page 338), found iron in centerline of Crosby Lake Road, 672.50' west of Centerline Hillsboro Road
1975- Edward Anderson #11495 (Unrecorded survey), found iron in centerline of Crosby Lake Road, 672.50' west on intersection of Hillsboro Road
1977- John Albright #10057 (LCRC Liber 7455 Page 852), found 1/2" rerod
1984- Sheldon Brown #17613 (Unrecorded survey), no monument described
1985- Edward Anderson #11495 (Unrecorded survey), iron in centerline of Crosby Lake Road, 672' west of centerline of Hillsboro Road

Distances table with columns: Distances, F-13 to E-13, 2660.82', (Wade-Trim - 1997); F-13 to G-13, 2691.00', (Kostecke - 1970); F-13 to G-13, 2689.68', (Wade-Trim - 1997); F-13 to F-1 White Lake, 103.73' east, (Albright - 1977); F-13 to F-1 White Lake, 102.97' east, (Wade-Trim - 1997)

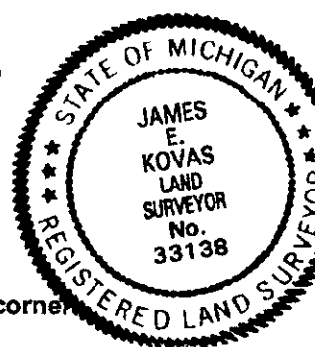

B. Description of corner evidence found and/or method applied in restoring or reestablishing corner:

F-13 Found 1/2" rerod

WITNESSES FOUND: Found iron at centerline of Hillsboro Road 671.5' east. East 103.76' to set 5/8" rerod (North 1/4 corner Sec. 4, T3N, R8E) Found 102.87'
Distance measured east to found iron: 672.11' (Wade-trim - 1997), 672.5' (Anderson), 671.98' (Albright), 672.5' (Kostecke)

C. Description of monument for corner and accessories established to perpetuate locating the position of the corner:

F-13 Set 5/8" iron and Remon Cap #33138

WIT: N 75 E 165.65' set remon. Tag w/ mag nail in NW face P.Pole
S 70 E 163.09' set remon. Tag w/ mag nail in NE face P. Pole
N 70 W 152.04 set remon. Tag w/ mag nail in S face (P. Pole is not very old - 5 yrs.)
East 102.97' to Remon Cap at F-1, the North 1/4 corner of Section 4, T3N, R8E

Signed by James E. Kovas Date 9/10/98

Surveyor's Michigan License No. 33138

700 FILE
200