

MAR 11 1999

LIBER 19238 PC013

10E-4 98 34 7654

SECTION

LAND CORNER RECORDATION CERTIFICATE  
Filing Requirement of Act 74, Mich. P.A. 1970

For corners in

Oakland (County)	Located In:	Corner Code #
1. Public Land Survey	T 4N R 8E	G-4
	T R	
	T R	
	T R	
2. Property Controlling in Section	S T R	
	S T R	
3. Miscellaneous Property in Sec.	S T R	
	S T R	

\$ 9.00 MISCELLANEOUS RECORDING  
 \$ 2.00 REMONUMENTATION  
 4 DEC 98 8:36 A.M. RECEIPT# 48  
 PAID RECORDED - OAKLAND COUNTY  
 G. WILLIAM CADWELL  
 CLERK/REGISTER OF DEEDS  
 Compliance with  
 ACT 345, P.A. 1990

APPROVED ON: 1-20-98 JS  
 OAKLAND COUNTY REMONUMENTATION  
 PEER GROUP COMMITTEE

Register of Deeds Stamp & File Number

4. Lot No. \_\_\_\_\_, Recorded Plat \_\_\_\_\_  
 5. Private Claims \_\_\_\_\_

I, Grant J. Ward, R.L.S., in a field survey on December 1, 1997 do hereby state that under requirements of P.A. 74, Michigan P.A. of 1970, the corner points mentioned in lines 1 and 2 above were in conformance with regulations and rules therefore as required in the current manual of survey instructions of the United States Department of the Interior, Bureau of Land Management or by a decree of a Court of Law and for that the corner points mentioned in lines 3, 4 and 5 above were in conformance with the rules of the Michigan Board of Land Surveyors or by a Decree of a Court of Law, established, re-established, monumented, recovered, found as expressed below:

NOTE: Not more than 2 corners, all in the same town and range, may be recorded on this certificate.

	A	B	C	D	E	F	G	H	I	J	K	L
1												
2	6	5	4	3	2	1						
3												
4	7	8	9	10	11	12						
5												
6	18	17	16	15	14	13						
7												
8	19	20	21	22	23	24						
9												
10	30	29	28	27	26	25						
11												
12	31	32	33	34	35	36						
13												

A. Description of original monument and accessories and/or subsequent restoration:

G-4 Post, per G.L.O. Notes.

B. Description of corner evidence found and/or method applied in restoring or reestablishing corner:


G-4 West 1/4 Corner of Section 10, T. 4 N., R. 8 E. Found 3/4" Pinch Pipe.

Previously Recorded in L. 6144 P. 849 (3), L. 7378 P. 601 (3), L. 7474 P. 668 (4) and L. 8324 P. 668 (4) of Oakland County Records.

(n) Indicates the number of references that confirms this corner by dimensional tie.

This corner location is accepted by the contractor and is generally accepted by professional surveyors as the best available evidence of the position of the original corner.

C. Description of monument for corner and accessories established to perpetuate locating the position of the corner:

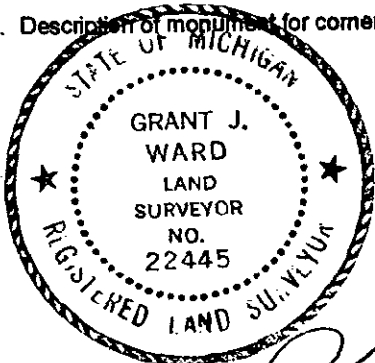

- G-4 Set Monument & Brass Cap.
- N 30° E 22.00' Set MAG Nail & Remonumentation Disc in West face of 8" Triple Cherry.
- N 50° E 5.34' Set MAG Nail & Remonumentation Disc in West face of 20" Hickory.
- S 80° E 18.64' Set MAG Nail & Remonumentation Disc in South face of 10" Cherry.
- S 30° E 3.48' Set MAG Nail & Remonumentation Disc in Northeast face of 36" Oak.

Signed by [Signature]  
 Surveyor's Michigan License No. 22445

Date January 2, 1998

9:00 FILE

MAR 21 1999

SECTION

JANUARY 8, 1998

Corner Code: G-4

DOSSIER FOR: THE EAST 1/4 CORNER OF SECTION 9, SPRINGFIELD TOWNSHIP,  
T 4 N, R 8 E, OAKLAND COUNTY, MICHIGAN. Prepared under contract with the  
County of Oakland Under Act 345 of the Public Acts of 1990.

HISTORY:

The boundary of this Township was surveyed by Alex Holmes, D.S. in 1815 and Joseph  
Wampler, D.S. set the Corners for the subdivision of it in 1823.

SPECIAL NOTES:

This Corner has been accepted and used since before 1963 as witnessed by the Road  
Commission for Oakland County at that time. It was recorded under Act 74 of the  
Public Acts of 1970 in Liber 6144, Page 849, by Marvin D. Pike, Surveyor in  
1973.

COLLATERAL EVIDENCE:

This Corner lies on a fence line 110 feet South of the Northwest corner of a fence.  
There is no other evidence of occupation North or South of this Corner.  
We searched at least 50 feet in each direction for other stakes and found none that  
might represent the Corner.  
The measured dimensions to the Northeast Corner and the Southeast Corner of Section 9  
agree with the recorded dimensions within 0.3 feet and 3 feet respectively.

SURVEYOR'S RECOMMENDATIONS:

The selected location is accepted by the Contractor and is generally accepted by Profes-  
sional Surveyors as the best available evidence of the position of the original Cor-  
ner. Therefore, I recommend that the Peer Review Group accept this Corner as  
monumented, with the references as shown on the enclosed form prepared accord-  
ing to Act 74 of the Public Acts of 1970.

---

Grant J. Ward, R.L.S.  
License No. 22445