

MAY 24 2000

LIBER 19832 PG 775

SECTION

LAND CORNER RECORDATION CERTIFICATE  
Filing Requirement of Act 74, Mich. P.A. 1970

128331

For corners in

Oakland	Located In:	Corner Code #
(County)		
1. Public Land Survey	T 4N R 8E	G-11
	T R	
	T R	
	T R	
2. Property Controlling in Section	S T R	
	S T R	
3. Miscellaneous Property in Sec.	S T R	
	S T R	

LIBER 19832 PAGE 775  
 \$9.00 MISC RECORDING  
 \$2.00 REMONUMENTATION  
 04/14/1999 01:54:01 P.M. RECEIPT# 18962  
 PAID RECORDED - OAKLAND COUNTY  
 G. WILLIAM CADDELL, CLERK/REGISTER OF DEEDS

Compliance with ACT 345, P.A. 1990

APPROVED ON: 2-24-99 JS  
 OAKLAND COUNTY REMONUMENTATION  
 PEER GROUP COMMITTEE  
 Register of Deeds Stamp & File Number

4. Lot No. \_\_\_\_\_, Recorded Plat \_\_\_\_\_  
 5. Private Claims \_\_\_\_\_

I, Grant J. Ward, R.L.S., in a field survey on September 1, 1998 do hereby state that under requirements of P.A. 74, Michigan P.A. of 1970, the corner points mentioned in lines 1 and 2 above were in conformance with regulations and rules therefore as required in the current manual of survey instructions of the United States Department of the Interior, Bureau of Land Management or by a decree of a Court of Law and /or that the corner points mentioned in lines 3, 4 and 5 above were in conformance with the rules of the Michigan Board of Land Surveyors or by a Decree of a Court of Law; established, re-established, monumented, recovered, found as expressed below:

NOTE: Not more than 2 corners, all in the same town and range, may be recorded on this certificate.

A	B	C	D	E	F	G	H	I	J	K	L	M
1												
2	6	5	4	3	2	1						
3												
4	7	8	9	10	11	12						
5												
6	18	17	16	15	14	13						
7												
8	19	20	21	22	23	24						
9												
10	30	29	28	27	26	25						
11												
12	31	32	33	34	35	36						
13												

A. Description of original monument and accessories and/or subsequent restoration:

G-11 Post, per G.L.O. Notes.

B. Description of corner evidence found and/or method applied in restoring or reestablishing corner:

G-11 Northeast Corner of Section 33, T. 4 N., R. 8 E. Found Iron Rod & Cap #10057.

Previously unrecorded.

(n) Indicates the number of references that confirms this corner by dimensional tie.


This corner location is accepted by the contractor and is generally accepted by professional surveyors as the best available evidence of the position of the original corner.

LP  
R

C. Description of monument for corner and accessories established to perpetuate locating the position of the corner:

G-11 Set Monument and Remonumentation Cap.

- S 70° E 4.64' Set 60d Nail & Remonumentation Disc in North face of 6" Maple.
- S 65° W 5.93' Set 60d Nail & Remonumentation Disc in North face of 6" Cherry.
- N 75° W 6.75' Set 60d Nail & Remonumentation Disc in North face of 6" Cherry.
- N 05° W 20.80' Set MAG Nail & Remonumentation Disc in East face of 10" Ash.

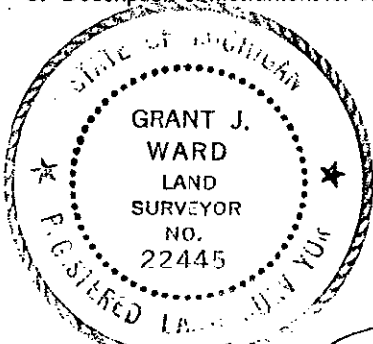

Signed by \_\_\_\_\_  
 Surveyor's Michigan License No. 22445

Date January 29, 1999