

MAR 11 1999

IDE-498347662

SECTION

LIBER 19238 PC029

LAND CORNER RECORDATION CERTIFICATE

Filing Requirement of Act 74, Mich. P.A. 1970 \$ 9.00 MISCELLANEOUS RECORDING

For corners in

Oakland (County)	Located In:	Corner Code #
1. Public Land Survey	T 4NR 8E	H-7
	T R	
	T R	
	T R	
2. Property Controlling in Section	S T R	
	S T R	
3. Miscellaneous Property in Sec.	S T R	
	S T R	

\$ 2.00 REMONUMENTATION  
 4 DEC 98 8:37 A.M. RECEIPT PAID  
 G. WILLIAM CADDELL  
 CLERK/REGISTER OF DEEDS  
 RECORDED - OAKLAND COUNTY


Compliance with  
 ACT 345, P.A. 1990

APPROVED ON: 2-04-98 JS  
 OAKLAND COUNTY REMONUMENTATION  
 PEER GROUP COMMITTEE

Register of Deeds Stamp & File Number

4. Lot No. \_\_\_\_\_, Recorded Plat \_\_\_\_\_  
 5. Private Claims \_\_\_\_\_

I, Grant J. Ward, R.L.S., in a field survey on January 27, 98 do hereby state that under requirements of P.A. 74, Michigan P.A. of 1970, the corner points mentioned in lines 1 and 2 above were in conformance with regulations and rules therefore as required in the current manual of survey instructions of the United States Department of the Interior, Bureau of Land Management or by a decree of a Court of Law and /or that the corner points mentioned in lines 3, 4 and 5 above were in conformance with the rules of the Michigan Board of Land Surveyors or by a Decree of a Court of Law; established, re-established, monumented, recovered, found as expressed below:

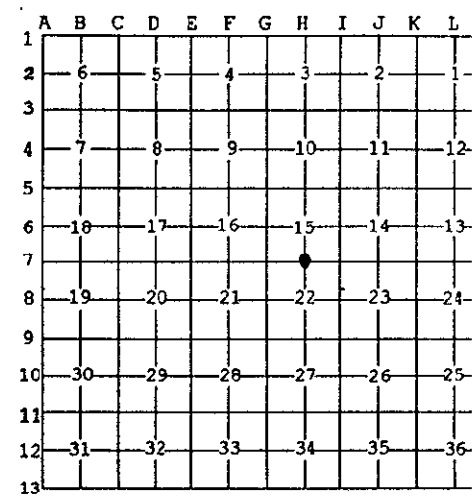

NOTE: Not more than 2 corners, all in the same town and range, may be recorded on this certificate.


A. Description of original monument and accessories and/or subsequent restoration:

H-7 Post, per G.L.O. Notes.

B. Description of corner evidence found and/or method applied in restoring or reestablishing corner:

H-7 North 1/4 Corner of Section 22, T. 4 N., R. 8 E. Found 5/8" Iron Rod.  
 Previously Recorded in L. 7593 P. 303 (2) of Oakland County Records.  
 (n) Indicates the number of references that confirms this corner by dimensional tie.  
 This corner location is accepted by the contractor and is generally accepted by professional surveyors as the best available evidence of the position of the original corner.

C. Description of monument for corner and accessories established to perpetuate locating the position of the corner:

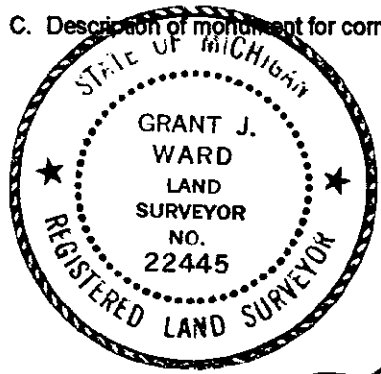

H-7 Set Monument and Remonumentation Cap.  
 N 05° E 20.67' Set MAG Nail & Remonumentation Disc in Southwest face of 14" Triple Oak.  
 East 30.97' Set MAG Nail & Remonumentation Disc in South face of 8" Oak.  
 South 24.54' Set MAG Nail & Remonumentation Disc in West face of 26" Oak.  
 N 65° W 21.28' Set MAG Nail & Remonumentation Disc in South face of 6" Oak.

Signed by \_\_\_\_\_  
 Surveyor's Michigan License No. 22445

Date January 30, 1998

900 FILE

MAR 11 1999

LIBER 19238PG030

SECTION

FEBRUARY 2, 1998

Corner Code: H-7

DOSSIER FOR: THE SOUTH 1/4 CORNER OF SECTION 15, SPRINGFIELD TOWNSHIP, T 4 N, R 8 E, OAKLAND COUNTY, MICHIGAN. Prepared under contract with the County of Oakland Under Act 345 of the Public Acts of 1990.

HISTORY:

The boundary of this Township was surveyed by Alex Holmes, D.S. in 1815 and Joseph Wampler, D.S. set the Corners for the subdivision of it in 1823.

SPECIAL NOTES:

This Corner has been accepted and used since before 1979, as recorded under Act 74 of the Public Acts of 1970 by James Smith, Surveyor as recorded in Liber 7593, Page 303.

COLLATERAL EVIDENCE:

This Corner lies on the East edge of a rock row and tree line running North and South. There is no evidence of occupation running East or West from this Corner. We searched at least 50 feet in each direction for other stakes and found none that might represent the Corner. We have no recorded dimensions in our files from this Corner to the Southwest Corner and the Southeast Corner of Section 15.

SURVEYOR'S RECOMMENDATIONS:

The selected location is accepted by the Contractor and is generally accepted by Professional Surveyors as the best available evidence of the position of the original Corner. Therefore, I recommend that the Peer Review Group accept this Corner as monumented, with the references as shown on the enclosed form prepared according to Act 74 of the Public Acts of 1970.

---

Grant J. Ward, R.L.S.  
License No. 22445

LIBER 19238PG030