

MAY 24 2000

SECTION

LIBER 19238PG031

LAND CORNER RECORDATION CERTIFICATE

Filing Requirement of Act 74, Mich. P.A. 1970 \$ 9.00 MISCELLANEOUS RECORDING

For corners in

Oakland (County)

Located in:

Corner Code #

- 1. Public Land Survey T 4NR 8E H-9
2. Property Controlling in Section S T R
3. Miscellaneous Property in Sec. S T R

\$ 2.00 REMONUMENTATION
4 DEC 98 8:37 A.M. RECEIPT# 4B
PAID RECORDED - OAKLAND COUNTY
G. WILLIAM CAIBELL
CLERK/REGISTER OF DEEDS

Compliance with ACT 345, P.A. 1990

APPROVED ON: 4-08-98 JS
OAKLAND COUNTY REMONUMENTATION
PEER GROUP COMMITTEE

Register of Deeds Stamp & File Number

- 4. Lot No. , Recorded Plat
5. Private Claims

I, Grant J. Ward, R.L.S., in a field survey on February 5, 19 98 do hereby state that under requirements of P.A. 74, Michigan P.A. of 1970, the corner points mentioned in lines 1 and 2 above were in conformance with regulations and rules therefore as required in the current manual of survey instructions of the United States Department of the Interior, Bureau of Land Management or by a decree of a Court of Law and /or that the corner points mentioned in lines 3, 4 and 5 above were in conformance with the rules of the Michigan Board of Land Surveyors or by a Decree of a Court of Law; established, re-established, monumented, recovered, found as expressed below:

NOTE: Not more than 2 corners, all in the same town and range, may be recorded on this certificate.

Grid table with columns A-M and rows 1-13. A dot is marked at row 9, column H.

A. Description of original monument and accessories and/or subsequent restoration:

H-9 Post, per G.L.O. Notes.

B. Description of corner evidence found and/or method applied in restoring or reestablishing corner:

H-9 North 1/4 Corner of Section 27, T. 4 N., R. 8 E. Found 1/2" Iron Rod 2' South of Centerline of Big Lake Road.


Previously Recorded in L. 7177 P. 616 (3) (4) of Oakland County Records.

(n) Indicates the number of references that confirms this corner by dimensional tie.

This corner location is accepted by the contractor and is generally accepted by professional surveyors as the best available evidence of the position of the original corner.

900 FILE
20

C. Description of monument for corner and accessories established to perpetuate locating the position of the corner:

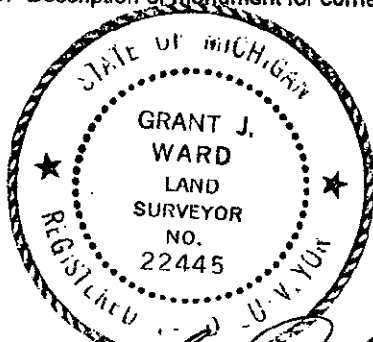

- H-9 Set 5/8" Iron Rod and Remonumentation Cap in Monument Box.
S 70° E 73.66' Set MAG Nail & Remonumentation Disc in North face of 36" Oak.
S 60° E 44.55' Set MAG Nail & Remonumentation Disc in South face of Oak Cluster.
N 25° W 47.08' Set MAG Nail & Remonumentation Disc in East face of 8" Maple.
N 05° W 28.64' Set MAG Nail & Remonumentation Disc in West face of Power Pole.

Signed by [Signature]
Surveyor's Michigan License No. 22445

Date February 17, 1998