

MAY 24 2000

LIBER 19832PG771

SECTION

LAND CORNER RECORDATION CERTIFICATE
Filing Requirement of Act 74, Mich. P.A. 1970

128329

For corners in

Oakland (County)	Located in:	Corner Code #
1. Public Land Survey	T 4NR 8E	H-11
	T R	
	T R	
	T R	
2. Property Controlling in Section	S T R	
	S T R	
3. Miscellaneous Property in Sec.	S T R	
	S T R	

LIBER 19832 PAGE 771
 \$9.00 MISC RECORDING
 \$2.00 REMONUMENTATION
 04/14/1999 01:54:01 P.M. RECEIPT# 18962
 PAID RECORDED - OAKLAND COUNTY
 G. WILLIAM CADDELL, CLERK/REGISTER OF DEED

Compliance with ACT 345, P.A. 1990

APPROVED ON: 2-24-99 JS
 OAKLAND COUNTY REMONUMENTATION
 PEER GROUP COMMITTEE

Register of Deeds Stamp & File Number

4. Lot No. _____, Recorded Plat _____
 5. Private Claims _____

I, Grant J. Ward, R.L.S., in a field survey on September 21st 1998 do hereby state that under requirements of P.A. 74, Michigan P.A. of 1970, the corner points mentioned in lines 1 and 2 above were in conformance with regulations and rules therefore as required in the current manual of survey instructions of the United States Department of the Interior, Bureau of Land Management or by a decree of a Court of Law and /or that the corner points mentioned in lines 3, 4 and 5 above were in conformance with the rules of the Michigan Board of Land Surveyors or by a Decree of a Court of Law, established, re-established, monumented, recovered, found as expressed below:

NOTE: Not more than 2 corners, all in the same town and range, may be recorded on this certificate.

	A	B	C	D	E	F	G	H	I	J	K	L
1												
2	6		5		4		3		2		1	
3												
4	7		8		9		10		11		12	
5												
6	10		17		16		15		14		13	
7												
8	19		20		21		22		23		24	
9												
10	30		29		28		27		26		25	
11												
12	31		32		33		34		35		36	
13												

A. Description of original monument and accessories and/or subsequent restoration:

H-11 Post, per G.L.O. Notes.

B. Description of corner evidence found and/or method applied in restoring or reestablishing corner:


H-11 North 1/4 Corner of Section 34, T. 4 N., R. 8 E.

Previously Unrecorded.

This corner location is a careful & faithful reestablishment of the position of the original corner by single proportion measurement by the contractor.

C. Description of monument for corner and accessories established to perpetuate locating the position of the corner:

- H-11 Set Monument & Remonumentation Cap.
- N 50° E 7.85' Set 60d Nail & Remonumentation Disc in Southeast face of 6" Hickory.
- S 80° E 16.27' Set 60d Nail & Remonumentation Disc in South face of 6" Hickory.
- West 6.45' Set 60d Nail & Remonumentation Disc in South face of 10" Maple.
- N 30° W 5.86' Set 60d Nail & Remonumentation Disc in Northeast face of 12" Ash.

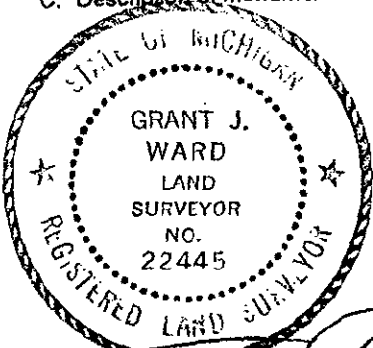

Signed by _____
 Surveyor's Michigan License No. 22445

Date January 29, 1999