LIBER 19012 PG 357

LAND CORNER RECORDATION CERTIFICATE
Filing Requirement of Act 74, Mich. P.A. 1970

For corners in

Oakland (county) Located In: Corner Code #

1. Public Land Survey T 4N R 8E H-13
   T___ R___
   T___ R___
   T___ R___
2. Property Controlling S___ T___ R___
   in Section S___ T___ R___
3. Miscellaneous S___ T___ R___
   Property in Sec. S___ T___ R___

$ 7.00 MISCELLANEOUS RECORDING
$ 2.00 REMONUMENTATION
2 OCT 98 8:45 A.M. RECEIPT# 8A
PAID RECORDED - OAKLAND COUNTY
LYNN D. ALLEN, CLERK/REGISTER OF DEEDS

Compliance with
ACT 345, P.A. 1990
APPROVED ON: 11-8-97-55
OAKLAND COUNTY REMONUMENTATION
PEER GROUP COMMITTEE
Register of Deeds Stamp & File Number

SURVEY & REMONUMENTATION
MAR 21 2000

SECTION

4. Lot No. _____, Recorded Plat _____
5. Private Claims _____

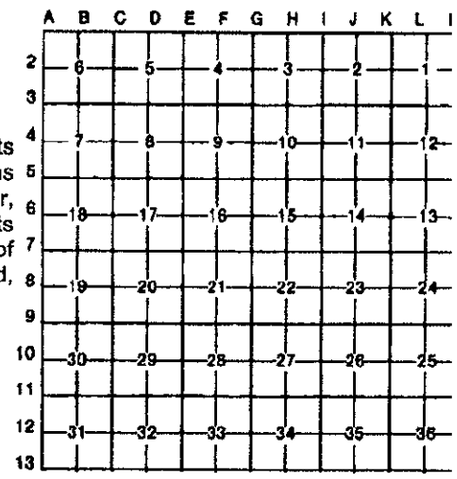

I, James E. Kovas, in a field survey on September 23, 1997, do hereby certify that under requirements of P.A. 74, Michigan P.A. of 1970, the corner points mentioned in lines 1 and 2 above were in conformance with regulations and rules therefore as required in the current manual of survey instructions of the United States Department of the Interior, Bureau of Land Management or by a decree of a Court of Law and/or that the corner points mentioned in lines 3, 4 and 5 above were in conformance with the rules of the Michigan Board of Land Surveyors or by a Decree of a Court of Law; established, re-established, monumented, re-monumented, recovered, found as expressed below:

NOTE: Not more than 4 corners, all in the same town and range, may be recorded on this certificate.

A. Description of original monument and accessories and/or subsequent restoration:
H-13
1823- Government Land Office (G.L.O.) Wampler, D.S., set standard corner post on township line
1890 ?- Baldwin - County Survey (Unrecorded survey), no monument described
1970- Ray Kostecke (Unrecorded survey), no monument described

Distances:	H-13 to G-13	2652.0'	(Kostecke - 1970)
	H-13 to G-13	2652.00'	(Wade-Trim - 1997)
			(H-13 was reset from Kostecke survey 1970)
	H-13 to I-13	2661.08'	(Wade-Trim - 1997)
	H-13 to H-1(W. Lake)	38.68' east	(Wade-Trim - 1997)

B. Description of corner evidence found and/or method applied in restoring or reestablishing corner:
H-13 Set 1/2" iron

WITNESSES FOUND: Corner was reset from 1970 Kostecke survey showing 2652.0' from G-13 to H-13. Corner was reset on line from G-13 to I-1.

C. Description of monument for corner and accessories established to perpetuate locating the position of the corner:
H-13 Set 5/8" Iron Rod with Remon Cap #33138 @ Bituminous Grade of East-West foot trail

WIT: N 30 W 39.43' Set 40d nail/Remon Cap #33138 SW face 15" Red Oak
N 80 E 103.66' Set 40d nail/Remon Cap #33138 SE face 19" White Oak
S 30 W 112.75 Set 40d nail/Remon Cap #33138 SW face 15" Locust
East 38.74' 5/8" iron with Remon Cap #33138, H-1, T3N, R8E, White Lake Township

7.00 FILE
2.00

STATE OF MICHIGAN
JAMES E. KOVAS
LAND SURVEYOR
No. 33138
REGISTERED LAND SURVEYOR

Signed by James E Kovas Date 9/16/98

Surveyor's Michigan License No. 33138

FORM APPROVED BY MICHIGAN STATE BOARD OF LAND SURVEYORS, JAN. 28, 1971
REVISED MAY 14, 1975
REVISED JAN., 1983