

MAY 24 2000

LIBER 19238 PC033

SECTION

LAND CORNER RECORDATION CERTIFICATE  
Filing Requirement of Act 74, Mich. P.A. 1970

\$ 9.00 MISCELLANEOUS RECORDING  
\$ 2.00 REMONUMENTATION  
4 DEC 98 8:37 A.M. RECEIPT 98  
PAID RECORDED - OAKLAND COUNTY  
G. WILLIAM CATDELL  
CLERK/REGISTER OF DEEDS

For corners in

Oakland (County)	Located In:	Corner Code #
1. Public Land Survey	T 4NR 8E	1-1
	T R	
	T R	
	T R	
2. Property Controlling In Section	S T R	
	S T R	
3. Miscellaneous Property in Sec.	S T R	
	S T R	

Compliance with  
ACT 345, P.A. 1990  
APPROVED ON: 4-08-98 JS  
OAKLAND COUNTY REMONUMENTATION  
PEER GROUP COMMITTEE

Register of Deeds Stamp & File Number

4. Lot No. \_\_\_\_\_, Recorded Plat \_\_\_\_\_  
5. Private Claims \_\_\_\_\_

	A	B	C	D	E	F	G	H	I	J	K	L	M
1													
2	6		5		4		3		2		1		
3													
4	7		8		9		10		11		12		
5													
6	18		17		16		15		14		13		
7													
8	19		20		21		22		23		24		
9													
10	30		29		28		27		26		25		
11													
12	31		32		33		34		35		36		
13													

I, Grant J. Ward, R.L.S., in a field survey on October 15, 1997 do hereby state that under requirements of P.A. 74; Michigan P.A. of 1970, the corner points mentioned in lines 1 and 2 above were in conformance with regulations and rules therefore as required in the current manual of survey instructions of the United States Department of the Interior, Bureau of Land Management or by a decree of a Court of Law and /or that the corner points mentioned in lines 3, 4 and 5 above were in conformance with the rules of the Michigan Board of Land Surveyors or by a Decree of a Court of Law; established, re-established, monumented, recovered, found as expressed below:

NOTE: Not more than 2 corners, all in the same town and range, may be recorded on this certificate.

A. Description of original monument and accessories and/or subsequent restoration:

I-1 Post, per G.L.O. Notes.

B. Description of corner evidence found and/or method applied in restoring or reestablishing corner:

I-1 Northwest corner of Section 2, T. 4 N., R. 8 E. Set 1/2" Iron Rod & Cap from Previous Witness in Centerline of Kier Road 68' +/- East of Centerline of Oakhill Road.


Previously Recorded in L. 7947 P. 870 (4) of Oakland County Records.

(n) Indicates the number of references that confirms this corner by dimensional tie.

This corner location is accepted by the contractor and is generally accepted by professional surveyors as the best available evidence of the position of the original corner.

C. Description of monument for corner and accessories established to perpetuate locating the position of the corner:

- I-1 Set 5/8" Iron Rod and Remonumentation Cap.
- N 10° E 23.36' Set MAG Nail & Remonumentation Disc in West face of 18" Oak.
- S 15° E 21.04' Set MAG Nail & Remonumentation Disc in West face of 10" Oak.
- S 55° W 29.88' Set MAG Nail & Remonumentation Disc in North face of 8" Ash.
- N 45° W 39.47' Set MAG Nail & Remonumentation Disc in Southwest face of Twin 16" Oaks.
- West 67.88' Found 1/2" Iron Rod Southwest corner Section 35 T. 5 N., R. 8 E., Groveland Twp.
- West 3.98' Found 1/2" Iron Rod.

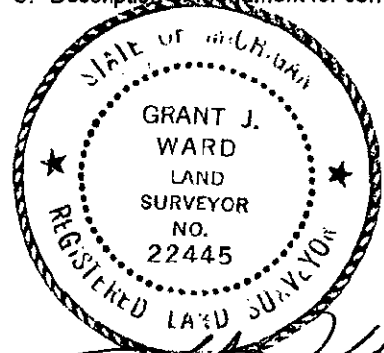

Signed by \_\_\_\_\_  
Surveyor's Michigan License No. 22445

Date February 12, 1998

C.D. FILE