

MAY 24 2000

LIBER 19238PG045

SECTION

LAND CORNER RECORDATION CERTIFICATE

Filing Requirement of Act 74, Mich. P.A. 1970 \$ 9.00 MISCELLANEOUS RECORDING

For corners in

Oakland (County)	Located In:	Corner Code #
1. Public Land Survey	T 4N R 8E	I-8
	T R	
	T R	
	T R	
2. Property Controlling in Section	S T R	
	S T R	
3. Miscellaneous Property in Sec.	S T R	
	S T R	

\$ 2.00 REMONUMENTATION
 4 DEC 98 8:38 A.M. RECEIPT# 48
 PAID RECORDED - OAKLAND COUNTY
 G. WILLIAM CADDELL
 CLERK/REGISTER OF DEEDS

Compliance with ACT 345, P.A. 1990

APPROVED ON: 1-08-98 JS
 OAKLAND COUNTY REMONUMENTATION
 PEER GROUP COMMITTEE

Register of Deeds Stamp & File Number

4. Lot No. _____, Recorded Plat _____
 5. Private Claims _____

I, Grant J. Ward, R.L.S., in a field survey on February 5, 1998 do hereby state that under requirements of P.A. 74; Michigan P.A. of 1970, the corner points mentioned in lines 1 and 2 above were in conformance with regulations and rules therefore as required in the current manual of survey instructions of the United States Department of the Interior, Bureau of Land Management or by a decree of a Court of Law and /or that the corner points mentioned in lines 3, 4 and 5 above were in conformance with the rules of the Michigan Board of Land Surveyors or by a Decree of a Court of Law; established, re-established, monumented, recovered, found as expressed below:

NOTE: Not more than 2 corners, all in the same town and range, may be recorded on this certificate.

A	B	C	D	E	F	G	H	I	J	K	L	M
1												
2	6	5			4		3		2		1	
3												
4	7	8			9		10		11		12	
5												
6	10	17			16		15		14		13	
7												
8	19	20			21		22	●	23		24	
9												
10	30	29			28		27		26		25	
11												
12	31	32			33		34		35		36	
13												

A. Description of original monument and accessories and/or subsequent restoration:

I-8 Post, per G.L.O. Notes.

B. Description of corner evidence found and/or method applied in restoring or reestablishing corner:

I-8 West 1/4 Corner of Section 23, T. 4 N., R. 8 E. Found 1/2" Iron Rod on Line with Centerline of Ridgewood Road South and East.


Previously Recorded in L. 6383 P. 865 (4), L. 9678 P. 460 (4) and L. 16049 P. 004 (4) of Oakland County Records.

(n) Indicates the number of references that confirms this corner by dimensional tie.

This corner location is accepted by the contractor and is generally accepted by professional surveyors as the best available evidence of the position of the original corner.

C. Description of monument for corner and accessories established to perpetuate locating the position of the corner:

- I-8 Set Monument & Remonumentation Cap.
- East 5.88' Set MAG Nail & Remonumentation Disc in North face of 14" Oak.
- S 20° W 18.80' Set MAG Nail & Remonumentation Disc in Southeast face of 16" Oak.
- N 60° W 24.15' Set MAG Nail & Remonumentation Disc in Northeast face of 18" Oak.
- N 20° W 21.28' Set MAG Nail & Remonumentation Disc in Southwest face of 16" Oak.

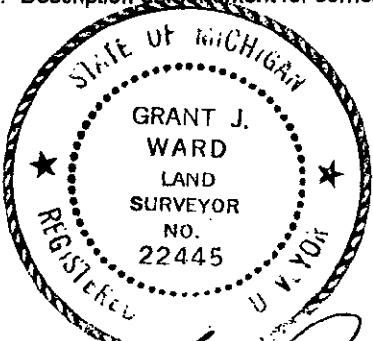

Signed by _____
 Surveyor's Michigan License No. 22445

Date February 17, 1998

900 FILE
200 FILE