

MAY 24 2000

SECTION

LIBER 19832 PG 769
LAND CORNER RECORDATION CERTIFICATE
Filing Requirement of Act 74, Mich. P.A. 1970

128328

For corners in

Oakland

(County)

Located in:

Corner Code #

1. Public Land Survey

T4N R8E

I-11

T R

T R

T R

2. Property Controlling in Section

S T R

S T R

3. Miscellaneous Property in Sec.

S T R

S T R

LIBER 19832 PAGE 769
\$9.00 MISC RECORDING
\$2.00 REMONUMENTATION
04/14/1999 01:54:01 P.M. RECEIPT# 18962
PAID RECORDED - OAKLAND COUNTY
G. WILLIAM CADDELL, CLERK/REGISTER OF DEEDS

Compliance with
ACT 345, P.A. 1990

APPROVED ON: 2-24-99 JS
OAKLAND COUNTY REMONUMENTATION
PEER GROUP COMMITTEE

Register of Deeds Stamp & File Number

4. Lot No. _____, Recorded Plat _____
5. Private Claims _____

Grant J. Ward, R.L.S., in a field survey on September 2, 1998 do hereby state that under requirements of P.A. 74, Michigan P.A. of 1970, the corner points mentioned in lines 1 and 2 above were in conformance with regulations and rules therefore as required in the current manual of survey instructions of the United States Department of the Interior, Bureau of Land Management or by a decree of a Court of Law and/or that the corner points mentioned in lines 3, 4 and 5 above were in conformance with the rules of the Michigan Board of Land Surveyors or by a Decree of a Court of Law; established, re-established, monumented, recovered, found as expressed below:

NOTE: Not more than 2 corners, all in the same town and range, may be recorded on this certificate.

	A	B	C	D	E	F	G	H	I	J	K	L
1												
2		6		5		4		3		2		
3												
4		7		8		9		10		11		
5												
6		18		17		16		15		14		
7												
8		19		20		21		22		23		
9												
10		30		29		28		27		26		
11												
12		31		32		33		34		35		
13												

A. Description of original monument and accessories and/or subsequent restoration:

I-11 Post, per G.L.O. Notes.

2p
R


B. Description of corner evidence found and/or method applied in restoring or reestablishing corner:

I-11 Northeast Corner of Section 34, T. 4 N., R. 8 E.

Previously unrecorded.

This corner location is a careful & faithful reestablishment of the position of the original corner by single proportion measurement by the contractor.

C. Description of monument for corner and accessories established to perpetuate locating the position of the corner:

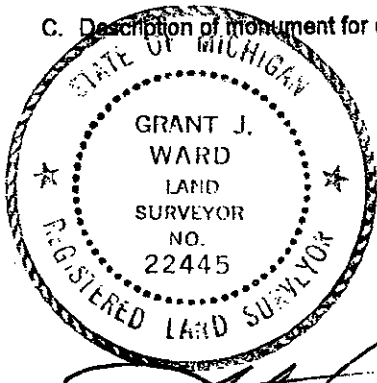

- I-11 Set Monument and Remonumentation Cap.
- N 80° E 25.83' Set 60d Nail & Remonumentation Disc in South face of 30" Maple.
- S 15° E 17.63' Set 60d Nail & Remonumentation Disc in West face of 36" Maple.
- West 32.23' Set 60d Nail & Remonumentation Disc in North face of 28" Maple.
- N 45° W 31.79' Set 60d Nail & Remonumentation Disc in West face of 28" Oak.

Signed by _____
Surveyor's Michigan License No. 22445

Date February 9, 1999