

MAR 2 1999

LIBER 19238 PG 067

189 4 98 3 4 7 6 8 1

SECTION

LAND CORNER RECORDATION CERTIFICATE
Filing Requirement of Act 74, Mich. P.A. 1970

For corners in

Oakland (County)	Located In:	Corner Code #
1. Public Land Survey	T 4NR 8E	K-6
	T R	
	T R	
	T R	
2. Property Controlling in Section	S T R	
	S T R	
3. Miscellaneous Property in Sec.	S T R	
	S T R	

4. Lot No. _____, Recorded Plat _____
5. Private Claims _____

I, Grant J. Ward, R.L.S., in a field survey on January 24, 1998 do hereby state that under requirements of P.A. 74, Michigan P.A. of 1970, the corner points mentioned in lines 1 and 2 above were in conformance with regulations and rules therefore as required in the current manual of survey instructions of the United States Department of the Interior, Bureau of Land Management or by a decree of a Court of Law and/or that the corner points mentioned in lines 3, 4 and 5 above were in conformance with the rules of the Michigan Board of Land Surveyors or by a Decree of a Court of Law; established, re-established, monumented, recovered, found as expressed below.

NOTE: Not more than 2 corners, all in the same town and range, may be recorded on this certificate.

\$ 9.00 MISCELLANEOUS RECORDING
 \$ 2.00 REMONUMENTATION
 4 DEC 98 8:40 A.M. RECEIPT# 48
 PAID RECORDED - OAKLAND COUNTY
 G. WILLIAM CADDELL
 CLERK/REGISTER OF DEEDS
 Compliance with
 ACT 345, P.A. 1990

APPROVED ON: 2-04-98 JS
 OAKLAND COUNTY REMONUMENTATION
 PEER GROUP COMMITTEE

Register of Deeds Stamp & File Number

	A	B	C	D	E	F	G	H	I	J	K	L
1												
2	6			5			4			3		2
3												
4	7						8			9		10
5												
6	10						17			16		15
7												
8	19						20			21		22
9												
10	30						29			28		27
11												
12	31						32			33		34
13												

A. Description of original monument and accessories and/or subsequent restoration:

K-6 Post, per G.L.O. Notes.

B. Description of corner evidence found and/or method applied in restoring or reestablishing corner:

K-6 East 1/4 Corner of Section 14, T. 4 N., R. 8 E. Found 5/8" Swamp Iron.


Previously Recorded in L. 9001 P. 565 (4), L. 13496 P. 301 (4), L. 15245 P. 582 (4), L. 15416 P. 184 (4) and L. 16037 P. 642 (4) of Oakland County Records.

(n) Indicates the number of references that confirms this corner by dimensional tie.

This corner location is accepted by the contractor and is generally accepted by professional surveyors as the best available evidence of the position of the original corner.

C. Description of monument for corner and accessories established to perpetuate locating the position of the corner:

- K-6 Set Monument and Remonumentation Cap.
- North 34.10' Set MAG Nail & Remonumentation Disc in West face of 6" Cedar.
- N 80° E 17.01' Set MAG Nail & Remonumentation Disc in South face of 8" Cedar.
- S 20° E 11.06' Set MAG Nail & Remonumentation Disc in East face of 14" Cedar.
- S 75° W 19.19' Set MAG Nail & Remonumentation Disc in North face of 7" Cedar.
- North 47.20' Found Iron Pipe.

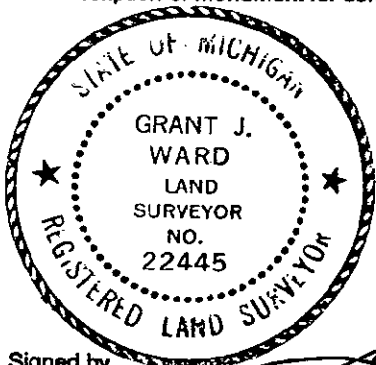

Signed by _____
Surveyor's Michigan License No. 22445

Date January 30, 1998

LIBER 19238 PG 067

900 FILE
200

FEB 1 1999

LIBER 19238PG068

SECTION

FEBRUARY 1, 1998

Corner Code: K-6

DOSSIER FOR: THE EAST 1/4 CORNER OF SECTION 14, SPRINGFIELD TOWNSHIP, T 4 N, R 8 E, OAKLAND COUNTY, MICHIGAN. Prepared under contract with the County of Oakland Under Act 345 of the Public Acts of 1990.

HISTORY:

The boundary of this Township was surveyed by Alex Holmes, D.S. in 1815 and Joseph Wampler, D.S. set the Corners for the subdivision of it in 1823.

SPECIAL NOTES:

This Corner has been accepted and used since before 1985, as evidenced by a recording under Act 74 of the Public Acts of 1970 by myself, Surveyor, in Liber 9001, Page 565.

COLLATERAL EVIDENCE:

This Corner lies in a swampy area at the Northwest corner of a broken wooden fence. We searched at least 50 feet in each direction for other stakes and found none that might represent the Corner.

The measured dimensions to the Northwest Corner and the Southwest Corner of Section 13 agree with the recorded distances within 0.2 feet and 0.01 feet respectively.

SURVEYOR'S RECOMMENDATIONS:

The selected location is accepted by the Contractor and is generally accepted by Professional Surveyors as the best available evidence of the position of the original Corner. Therefore, I recommend that the Peer Review Group accept this Corner as monumented, with the references as shown on the enclosed form prepared according to Act 74 of the Public Acts of 1970.

Grant J. Ward, R.L.S.
License No. 22445

LIBER 19238PG068