

MAY 24 2000

SECTION

LIBER 19238 PC 075

LAND CORNER RECORDATION CERTIFICATE  
Filing Requirement of Act 74, Mich. P.A. 1970

For corners in

Oakland (County)	Located In:	Corner Code #
1. Public Land Survey	T 4N R 8E	L-1
	T R	
	T R	
	T R	
2. Property Controlling in Section	S T R	
	S T R	
3. Miscellaneous Property in Sec.	S T R	
	S T R	

9.00 MISCELLANEOUS RECORDING  
 2.00 REMONUMENTATION  
 4 DEC 98 8:40 A.M. RECEIPT# 48  
 PAID RECORDED - OAKLAND COUNTY  
 G. WILLIAM CAIDELL  
 CLERK/REGISTER OF DEEDS

Compliance with ACT 345, P.A. 1990  
 APPROVED ON: 4-08-98 JS  
 OAKLAND COUNTY REMONUMENTATION PEER GROUP COMMITTEE

Register of Deeds Stamp & File Number

4. Lot No. \_\_\_\_\_, Recorded Plat \_\_\_\_\_  
 5. Private Claims \_\_\_\_\_

I, Grant J. Ward, R.L.S., in a field survey on October 14, 1997 do hereby state that under requirements of P.A. 74, Michigan P.A. of 1970, the corner points mentioned in lines 1 and 2 above were in conformance with regulations and rules therefore as required in the current manual of survey instructions of the United States Department of the Interior, Bureau of Land Management or by a decree of a Court of Law and/or that the corner points mentioned in lines 3, 4 and 5 above were in conformance with the rules of the Michigan Board of Land Surveyors or by a Decree of a Court of Law; established, re-established, monumented, recovered, found as expressed below:

NOTE: Not more than 2 corners, all in the same town and range, may be recorded on this certificate.

	A	B	C	D	E	F	G	H	I	J	K	L	M
1													
2	6		5		4			3		2		1	
3													
4	7		8		9			10		11		12	
5													
6	16		17		16			15		14		13	
7													
8	19		20		21			22		23		24	
9													
10	30		29		28			27		26		25	
11													
12	31		32		33			34		35		36	
13													

A. Description of original monument and accessories and/or subsequent restoration:  
 L-1 Post, per G.L.O. Notes.

B. Description of corner evidence found and/or method applied in restoring or reestablishing corner:


L-1 North 1/4 Corner of Section 1, T. 4 N., R. 8 E. Found 1/2" Iron Rod 8' +/- South of Centerline of Kier Road. (Also L-13 of Groveland Twp., T. 5 N., R. 8 E.).

Previously Recorded in L. 6409 P. 484 (2) of Oakland County Records.

(n) Indicates the number of references that confirms this corner by dimensional tie.

This corner location, although not established by an original government survey, is accepted by the contractor and is generally accepted by professional surveyors as the best available evidence of the position of the original corner.

C. Description of monument for corner and accessories established to perpetuate locating the position of the corner:

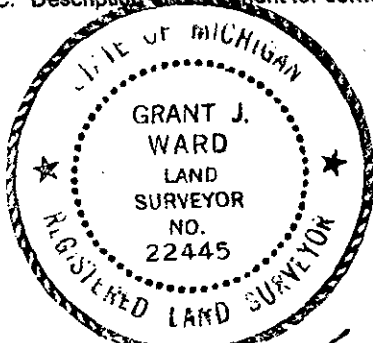

- L-1 Set 5/8" Iron Rod & Remonumentation Cap.
- N 70° E 72.64' Set MAG Nail & Remonumentation Disc in South face of 20" Oak.
- S 60° E 30.85' Set MAG Nail & Remonumentation Disc in North face of 8" Cherry.
- S 60° W 29.70' Set MAG Nail & Remonumentation Disc in North face of 18" Oak.
- N 60° W 60.77' Set MAG Nail & Remonumentation Disc in South face of 22" Hickory.

Signed by \_\_\_\_\_  
 Surveyor's Michigan License No. 22445

Date February 12, 1998

10E-4 98347685

500 FILE  
2.00