

PAID MAY 24 2000  
Springfield  
SECTION

LIB# 21143 077

LAND CORNER RECORDATION CERTIFICATE  
Filing Requirement of Act 74, Mich. P.A. 1970

58667

For corners in

Oakland Located In: Corner Code #  
(County)

- 1. Public Land Survey T4N R 8E L-9  
T R  
T R  
T R
- 2. Property Controlling S T R  
in Section S T R
- 3. Miscellaneous S T R  
Property in Sec. S T R

LIBER 21143 PAGE 77  
\$9.00 MISC RECORDING  
\$2.00 REMONUMENTATION  
02/28/2000 01:52:10 P.M. RECEIPT# 16297  
PAID RECORDED - OAKLAND COUNTY  
G. WILLIAM CADDELL, CLERK/REGISTER OF DEE

Compliance with  
ACT 345, P.A. 1990

APPROVED ON: 2-24-99 JS  
OAKLAND COUNTY REMONUMENTATION  
PEER GROUP COMMITTEE

Register of Deeds Stamp & File Number

- 4. Lot No. \_\_\_\_\_, Recorded Plat \_\_\_\_\_
- 5. Private Claims \_\_\_\_\_

I, Grant J. Ward, R.L.S., in a field survey of February 4, 1998 do hereby state that under requirements of P.A. 74, Michigan P.A. of 1970, the corner points mentioned in lines 1 and 2 above were in conformance with regulations and rules therefore as required in the current manual of survey instructions of the United States Department of the Interior, Bureau of Land Management or by a decree of a Court of Law and/or that the corner points mentioned in lines 3, 4 and 5 above were in conformance with the rules of the Michigan Board of Land Surveyors or by a Decree of a Court of Law, established, re-established, monumented, recovered, found as expressed below:

NOTE: Not more than 2 corners, all in the same town and range, may be recorded on this certificate.

1	A	B	C	D	E	F	G	H	I	J	K	L
2		6		5		4		3		2		1
3												
4		7		8		9		10		11		12
5												
6		18		17		16		15		14		13
7												
8		19		20		21		22		23		24
9												
10		30		29		28		27		26		25
11												
12		31		32		33		34		35		36
13												

A. Description of original monument and accessories and/or subsequent restoration:

L-9 Post, per G.L.O. Notes.

B. Description of corner evidence found and/or method applied in restoring or reestablishing corner:


L-9 South 1/4 Corner of Section 24, T. 4 N., R. 8 E. Found 1/2" Iron Rod & Cap "GPS MI 39086".  
Previously Unrecorded.

This corner location is accepted by the contractor and is generally accepted by professional surveyors as the best available evidence of the position of the original corner.

24  
R

C. Description of monument for corner and accessories established to perpetuate locating the position of the corner:

- L-9 Set Monument & Remonumentation Cap.
- N 50° E 69.87' Set MAG Nail & Remonumentation Disc in South face of 8" Pine.
- N 65° E 62.18' Set MAG Nail & Remonumentation Disc in South face of 10" Oak.
- S 35° E 111.37' Set MAG Nail & Remonumentation Disc in West face of 12" Oak.
- S 30° E 108.58' Set MAG Nail & Remonumentation Disc in East face of 10" Oak.

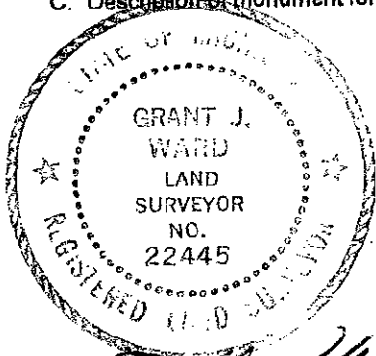

Signed by \_\_\_\_\_  
Surveyor's Michigan License No. 22445

Date January 25, 1999