

LIBER 19012PG363

LAND CORNER RECORDATION CERTIFICATE
Filing Requirement of Act 74, Mich. P.A. 1970

For corners in

Oakland (county) Located In: Corner Code #
1. Public Land Survey T 4N R 8E L-13
2. Property Controlling S T R
3. Miscellaneous S T R
Property in Sec. S T R

\$ 7.00 MISCELLANEOUS RECORDING
\$ 2.00 REMONUMENTATION
2 OCT 98 8:46 A.M. RECEIPT PAID
RECORDED - OAKLAND COUNTY
LYNN D. ALLEN, CLERK/REGISTER OF DEEDS


Compliance with ACT 345, P.A. 1990

APPROVED ON: 11-8-97 JS
OAKLAND COUNTY REMONUMENTATION
PEER GROUP COMMITTEE
Register of Deeds Stamp & File Number

SECTION

4. Lot No. Recorded Plat
5. Private Claims

I, James E. Kovas, in a field survey on August 22, 1997, do hereby certify that under requirements of P.A. 74, Michigan P.A. of 1970, the corner points mentioned in lines 1 and 2 above were in conformance with regulations and rules therefore as required in the current manual of survey instructions of the United States Department of the Interior, Bureau of Land Management or by a decree of a Court of Law and/or that the corner points mentioned in lines 3, 4 and 5 above were in conformance with the rules of the Michigan Board of Land Surveyors or by a Decree of a Court of Law; established, re-established, monumented, re-monumented, recovered, found as expressed below:

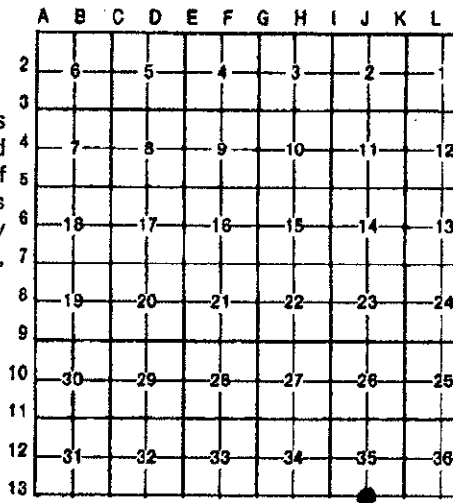


NOTE: Not more than 4 corners, all in the same town and range, may be recorded on this certificate.

A. Description of original monument and accessories and/or subsequent restoration:

- L-13
1823- Government Land Office (G.L.O) Wampler, D.S, section standard post set
Date?- Unknown surveyor (Unrecorded survey), no monument survey
1978- Boss Engineering, Gary Boss #17022(LCRC Liber 7783 Page 522), found 1/2" iron in centerline of White Lake Road
1981- Gary Boss #17022 (Survey Liber 8035 Page 492), no monument described
1989- Tom Smith #31606 (Unrecorded survey), no monument described
1991- Tom Smith #31606 (Unrecorded survey), Found 1/2" rerod
1993- Gary Boss #17022 (Survey liber 14737 Page 576), no monument described
1995- Grant Ward #22445 (LCRC Liber 15519 Pg 25), found iron in centerline of White Lake Road from previous description
Date?- Oakland County Road Commission (Witness notes), found iron pipe

Distances: L-13 to K-13 2664.39' (Wade-Trim - 1997)
L-13 to M-13 2639.86' (Survey - date ?)
L-13 to M-13 2640.21' (Boss - 1981)
L-13 to M-13 2627.00' (T. Smith - 1989)
L-13 to M-13 2639.89' (Wade-Trim - 1997)
L-13 to L-1 (White Lake) 6.71' east (Wade-Trim - 1997)
L-13 to L-1 (White Lake) 6.73' east (Tax map)

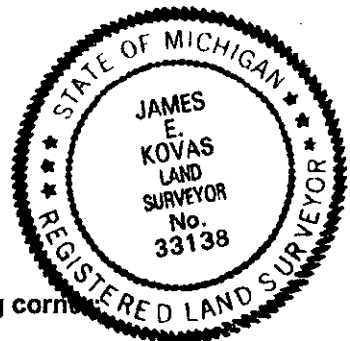

B. Description of corner evidence found and/or method applied in restoring or reestablishing corner

L-13 Found 1/2" iron rod

WITNESSES FOUND: N 15 W 25.22' to nail in East side 24" Oak Found 25.12'
N 55 W 57.30' to nail SW side telephone Pole Found 57.37'
S 40 W 50.80' to nail NW side power pole Found 50.78'
East 2640.21' to SE corner Section 36 Found 2639.89'
N 15 W 25.12' to found nail East side 24" Oak Found 25.12'
N 55 W 57.43' to found nail SW Side telephone Pole Found 57.37'
S 40 W 50.80' to found nail NW side power pole Found 50.78'
North 33.67' to set PK. disc 22445 in East side 4" Pine Found 33.69'
N 55 W 57.45' to nail in utility Pole Found 57.37'
N 10 W 25.41' to nail in 26" Oak Found 25.12'

700 FILE
200

C. Description of monument for corner and accessories established to perpetuate locating the position of the corner:

L-13 Set Remon Cap #33138 on 5/8" iron

- WIT: N 05 W 25.75' Set 60d Nail/Remon Tag #33138 East face 24" Red Oak
N 30 E 33.81' Set 60d Nail/Remon Tag #33138 East face 4" Pine
S 20 E 42.54' Set 60d Nail/Remon Tag #33138 East face Cottonwood stump in E-W fence line
S 45 W 50.83' Set 60d Nail/Remon Tag #33138 SW face utility pole

Signed by James S Kovas Date 9/10/98

Surveyor's Michigan License No. 33138

10. 298290129