

LAND CORNER RECORDATION CERTIFICATE
Filing Requirement of Act 74, Mich. P.A. 1970

For corners in Oakland (County) Located In: Corner Code #
1. Public Land Survey T 4N R 8E M-1
2. Property Controlling in Section S T R
3. Miscellaneous Property in Section S T R
4. Lot No. , Recorded Plat
5. Private Claims

\$ 7.00 MISCELLANEOUS RECORDING
\$ 2.00 REMONUMENTATION
23 FEB 98 11:12 A.M. RECEIPT# 156A
PAID RECORDED - OAKLAND COUNTY
LYNN D. ALLEN, CLERK/REGISTER OF DEEDS
Compliance with ACT 345, P.A. 1990
APPROVED ON: 1-14-98 JS
OAKLAND COUNTY REMONUMENTATION PEER GROUP COMMITTEE
Register of Deeds Stamp & File Number

SECTION


Grid table with columns A-L and rows 2-13. Contains numbers 6-36 in a grid pattern.

I, James J. Scharl, in a field survey on 11-17, 19 97, do hereby certify that under requirements of P.A. 74, Michigan P.A. of 1970, the corner points mentioned in lines 1 and 2 above were in conformance with regulations and rules therefore as required in the current manual of survey instructions of the United States Department of the Interior, Bureau of Land Management or by a decree of a Court of Law and/or that the corner points mentioned in lines 3, 4 and 5 above were in conformance with the rules of the Michigan Board of Professional Surveyors or by a Decree of a Court of Law; established, re-established, monumented, re-monumented, recovered, found as expressed below:

NOTE: Not more than 4 corners, all in the same town and range, may be recorded on this certificate.

A. Description of original monument and accessories and/or subsequent restoration:

Post set in 1815 G.L.O. survey; 16" W. oak S 54°W 33 lks, 15" W. oak N 10°E 19 lks.
LCRC, L 6409, P 482, O.C.R.
Feldhauser, 1974, 5/8" iron rod
S 22°E 39.50' Nail E 14" Cherry
S 09°E 66.63' Nail E 15" Oak
N 69°W 64.06' Nail N 14" Cherry
N 36°E 23.77' Nail W 30" Oak

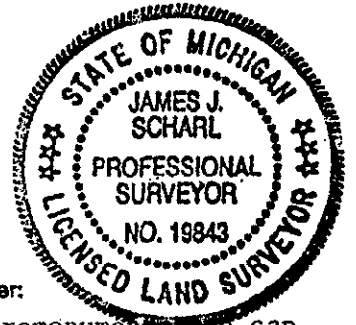

B. Description of corner evidence found and/or method applied in restoring or reestablishing corner:

Recovered a 1/2" rerod on 2-3-97 and a 5/8" rerod with O.C. brass remonumentation cap #22445 on 11-17-97 at the same point. The corner is located 3 ft east and 10 ft north of the centerline intersection of Kier and Ellis Roads. Corner position checks with local monumentation north, south & west and with G.L.O. reference to Corner A-1 in Independence Twp.; 1161.59' mea, 1160.94' G.L.O.

Witnesses Found

- *N 40°E 23.75' PK/tag 42" Oak
S 85°E 16.32' PK/tag 14" Oak
S 45°E 28.70' Nail tag guy pole
*N 40°E 23.88' PK/O.C. remon tag #22445 NW 42" Oak
*S 50°E 39.53' PK/O.C. remon tag #22445 SW 14" Cherry
S 45°W 42.13' PK/O.C. remon tag #22445 SE DE pole
*N 60°W 64.53' PK/O.C. remon tag #22445 S 20" Cherry

*Confirms LCRC

C. Description of monument for corner and accessories established to perpetuate locating the position of the corner:

Recovered 5/8" rerod with O.C. remonumentation brass cap with #22445.

N 40°E 23.88' NW 42" Oak PK/remon tag #22445 State Plane Coordinates
S 50°E 39.53' SW 14" Cherry PK/remon tag #22445 N 471211.9818
S 45°W 42.13' SE DE pole PK/remon tag #22445 E 13369478.9143
N 60°W 64.53' S 20" Cherry PK/remon tag #22445

The selected location is accepted by the Contractor and is generally accepted by professional surveyors as the best available evidence of the position of the original corner. This corner was also accepted by the Oakland County Peer Group as established under Act 345 of P.A. 1990.

Signed by James J. Scharl
Surveyor's Michigan License No. 19843

Date December 15, 1997

750 FILE
200