LIBER 18129 PAGE 492

LAND CORNER RECORDATION CERTIFICATE

Filing Requirement of Act 74, Mich. P.A. 1970

For corners in Oakland (County) Located In: Corner Code #

$ 7.00 MISCELLANEOUS RECORDING
$ 2.00 REMONUMENTATION
23 FEB 98 11:13 A.M. RECEIPT# 156A
PAID RECORDER - OAKLAND COUNTY
LYNN D. ALLEN, COUNTY CLERK/REGISTER OF DEEDS
ACT 345, P.A. 1990
APPROVED ON: 1-14-98 JS
OAKLAND COUNTY REMONUMENTATION PEER GROUP COMMITTEE
Register of Deeds Stamp & File Number

1. Public Land Survey — T 4N R 8E — M-6
2. Property Controlling in Section — S ___ T ___ R ___
3. Miscellaneous Property in Section — S ___ T ___ R ___

SURVEY & REMONUMENTATION MAR 21 2000

4. Lot No. _____, Recorded Plat _____ SECTION
5. Private Claims _____

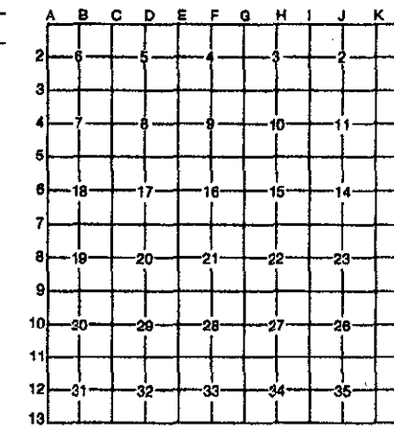

I, James J. Scharl, in a field survey on 11-17, 19 97, do hereby certify that under requirements of P.A. 74, Michigan P.A. of 1970, the corner points mentioned in lines 1 and 2 above were in conformance with regulations and rules therefore as required in the current manual of survey instructions of the United States Department of the Interior, Bureau of Land Management or by a decree of a Court of Law and/or that the corner points mentioned in lines 3, 4 and 5 above were in conformance with the rules of the Michigan Board of Professional Surveyors or by a Decree of a Court of Law; established, re-established, monumented, re-monumented, recovered, found as expressed below:

NOTE: Not more than 4 corners, all in the same town and range, may be recorded on this certificate.

A. Description of original monument and accessories and/or subsequent restoration:

Post set in 1815 G.L.O. survey; 16" W. oak S 24°W 11 lks; 6" W. oak N 25°E 22 lks.

LCRC, L 7601, P 814
Williams, 1979, Fd 1/2" pipe
*N 50°W 47.50' Nail SW 30" Oak
N 45°E 28.82' Nail NW 16" Oak
*S 15°E 25.30' Nail W 12" Hickory

LCRC, L 14993, P 798
Scharl, 1994, 1/2" pipe
*S 15°W 47.51' PK W 34" Oak
*N 85°W 29.07' PK N 18" Oak
*S 30°E 25.34' PK SW 16" Hickory
*N 05°W 120.65' PK E 22" Oak

B. Description of corner evidence found and/or method applied in restoring or reestablishing corner:

Recovered 1/2" iron pipe 18 ft south of the Holcomb Road centerline, 8" below grade. Corner was verified as referenced by recorded LCRC's and "Bridge Valley", recorded in L 235, P 21-25, O.C.R.

Witnesses Found
*S 15°W 47.51' PK W 34" Oak
*N 85°W 29.07' PK N 18" Oak
*S 30°E 25.34' PK SW 16" Hickory
*N 05°W 120.65' PK E 22" Oak
South 2611.01' (2611.44' rec) to SE corner of Section 13

*Confirms LCRC

STATE OF MICHIGAN
JAMES J. SCHARL
PROFESSIONAL SURVEYOR
NO. 19843
LICENSED LAND SURVEYOR

C. Description of monument for corner and accessories established to perpetuate locating the position of the corner:

Set 5/8" rerod with O.C. remonumentation brass cap, replacing 1/2" iron pipe.

S 15°W 47.51' PK/remon tag W side 34" Oak
N 85°W 29.07' PK/remon tag N side 18" Oak
S 30°E 25.34' PK/remon tag SW side 16" Hickory
N 05°W 120.65' PK/remon tag E side 22" Oak

State Plane Coordinates
N 457948.6280
E 13370060.6627

The selected location is a careful and faithful reestablishment of the position of the original corner. This corner was also accepted by the Oakland County Peer Group, as established under Act 345 of P.A. 1990.

Signed by James J. Scharl Date DECEMBER 15, 1997

Surveyor's Michigan License No. 19843

FORM APPROVED BY MICHIGAN STATE BOARD OF PROFESSIONAL SURVEYORS, JAN. 26, 1971
REVISED MAY 14, 1975
REVISED JAN., 1983