

LAND CORNER RECORDATION CERTIFICATE
Filing Requirement of Act 74, Mich. P.A. 1970

For corners in Oakland Located In: _____ Corner Code # _____
(County)

- | | | | | | |
|--------------------------------------|---|-----------|---|-----------|-------------|
| 1. Public Land Survey | T | <u>4N</u> | R | <u>8E</u> | <u>M-11</u> |
| | T | _____ | R | _____ | _____ |
| | T | _____ | R | _____ | _____ |
| | T | _____ | R | _____ | _____ |
| 2. Property Controlling in Section | S | _____ | T | _____ | R |
| | S | _____ | T | _____ | R |
| 3. Miscellaneous Property in Section | S | _____ | T | _____ | R |
| | S | _____ | T | _____ | R |

\$ 7.00 MISCELLANEOUS RECORDING
 \$ 2.00 REMONUMENTATION
 23 FEB 98 11:14 A.M. RECEIPT# 156A
 PAID RECORDED - OAKLAND COUNTY
 LYNN D. ALLEN, CLERK/REGISTER OF DEEDS
 ACT 345, P.A. 1990

APPROVED ON: 1-14-98 JS
 OAKLAND COUNTY REMONUMENTATION
 PEER GROUP COMMITTEE
Register of Deeds Stamp & File Number

4. Lot No. _____, Recorded Plat _____ SECTION _____
 5. Private Claims _____

A	B	C	D	E	F	G	H	I	J	K
2	6	5	4	3	2					
3										
4	7	6	5	4	3	2				
5										
6	18	17	16	15	14					
7										
8	19	20	21	22	23					
9										
10	30	29	28	27	26					
11										
12	31	32	33	34	35					
13										

I, James J. Scharl, in a field survey on 11-18, 19 97, do hereby certify that under requirements of P.A. 74, Michigan P.A. of 1970, the corner points mentioned in lines 1 and 2 above were in conformance with regulations and rules therefore as required in the current manual of survey instructions of the United States Department of the Interior, Bureau of Land Management or by a decree of a Court of Law and/or that the corner points mentioned in lines 3, 4 and 5 above were in conformance with the rules of the Michigan Board of Professional Surveyors or by a Decree of a Court of Law; established, re-established, monumented, re-monumented, recovered, found as expressed below:

NOTE: Not more than 4 corners, all in the same town and range, may be recorded on this certificate.

A. Description of original monument and accessories and/or subsequent restoration:

Post set in 1815 G.L.O. survey; 9" B. oak, N 38°W 4 lks; 8" W. oak, S 25°E 6 lks
 LCRC, L 12747, P 022
 Scharl, 1992, 5/8" rerod
 North 31.78' 10" R. oak
 S 80°E 12.76' 6" Box elder
 S 30°E 5.43' 3-20" Cherry
 West 34.51' 8" Cherry


B. Description of corner evidence found and/or method applied in restoring or reestablishing corner:

Recovered 5/8" rerod on North-South tree row. Corner set by Detroit Edison in 1961 and verified in 1992 by Kieft Engineering survey.

Witnesses Found

- *North 31.78' PK SE 12" Oak
- *S 30°E 5.43' PK W 20" Oak
- *West 34.51' PK S 10" Cherry

*Confirms LCRC

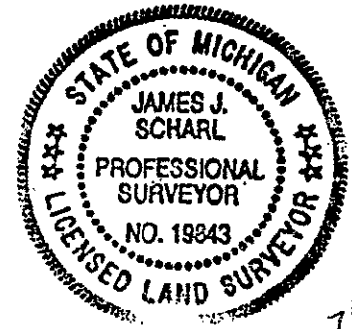

C. Description of monument for corner and accessories established to perpetuate locating the position of the corner:

Set concrete monument w/O.C. remonumentation brass cap, replacing 5/8" rerod

N 80°W 34.51' PK/remon tag S. face 10" Cherry	State Plane Coordinates
North 31.83' PK/remon tag E. face 12" Oak	N 444725.3164
S 60°E 12.90' PK/remon tag SW face 8" B. Elder	E 13370576.4995
S 30°E 3.22' PK/remon tag W. face tri-16" Cherry	

The selected location is accepted by the Contractor and is generally accepted by professional surveyors as the best available evidence of the position of the original corner. This corner was also accepted by the Oakland County Peer Group as established under Act 345 of P.A. 1990.

Signed by James J. Scharl
 Surveyor's Michigan License No. 19843

Date DECEMBER 15, 1997