

LIBER 19012PG362

LAND CORNER RECORDATION CERTIFICATE
Filing Requirement of Act 74, Mich. P.A. 1970

For corners in

Oakland Located In: Corner Code #
(county)

1. Public Land Survey T 4N R 8E K-13
T R
T R SURVEY &
T R REMONUMENTATION

2. Property Controlling S T R
in Section S T R

3. Miscellaneous S T R
Property in Sec. S T R MAR 21 2000

\$ 7.00 MISCELLANEOUS RECORDING
\$ 2.00 REMONUMENTATION
2 OCT 98 8:46 A.M. RECEIPTS BY
PAID RECORDED - OAKLAND COUNTY
LYNN D. ALLEN, CLERK/REGISTER OF DEEDS

Compliance with
ACT 345, P.A. 1990
APPROVED ON: 11-8-97 JS
OAKLAND COUNTY REMONUMENTATION
PEER GROUP COMMITTEE
Register of Deeds Stamp & File Number

SECTION

4. Lot No. _____, Recorded Plat _____

5. Private Claims _____

I, James E. Kovas, in a field survey on August 22, 1997,
do hereby certify that under requirements of P.A. 74, Michigan P.A. of 1970, the corner points
mentioned in lines 1 and 2 above were in conformance with regulations and rules therefore as
required in the current manual of survey instructions of the United States Department of the Interior,
Bureau of Land Management or by a decree of a Court of Law and/or that the corner points
mentioned in lines 3, 4 and 5 above were in conformance with the rules of the Michigan Board of
Land Surveyors or by a Decree of a Court of Law; established, re-established, monumented,
re-monumented, recovered, found as expressed below:

	A	B	C	D	E	F	G	H	I	J	K	L	M
2	6	5	4	3	2	1							
3													
4	7	8	9	10	11	12							
5													
6	18	17	16	15	14	13							
7													
8	19	20	21	22	23	24							
9													
10	30	29	28	27	26	25							
11													
12	31	32	33	34	35	36							
13													

NOTE: Not more than 4 corners, all in the same town and range, may be recorded on this certificate.

A. Description of original monument and accessories and/or subsequent restoration:
K-13

- 1823- Government Land Office (G.L.O) Wampler, D.S, set standard post set
- 1978- Boss Engineering, Gary Boss #17022(LCRC Liber 7783 Page 522), set 1/2" iron by intersecting found irons from the W 1/4 corner and found irons from the S 1/4 corner of Section 35
- 1978- Boss Engineering (Unrecorded survey), no monument described
- 1992- Tom Smith #31606 (Unrecorded survey), no monument described


Distances: K-13 to J-13 2700.62' (Wade-Trim - 1997)
K-13 to L-13 2664.39' (Wade-Trim - 1997)
K-13 to K-1 (White Lake) 54.12' east (82 links GLO)
K-13 to K-1 (White Lake) 54.12' east (Boss - 1978)
K-13 to K-1 (White Lake) 54.11' east (Wade-Trim - 1997)

B. Description of corner evidence found and/or method applied in restoring or reestablishing corner:
K-13 Found 1/2" iron rod

WITNESSES FOUND: East 54.12' NW corner Section 1 of White Lake Found 54.11"
East 54.12' to K-13 of Springfield Found 54.11"

C. Description of monument for corner and accessories established to perpetuate locating the position of the corner:
K-13 Reset W/Conc. Mon W/Brass Oakland Co. Remon Cap #33138

WIT: S 70 W 39.21' Set 60d Nail/Remon Tag #33138 South face 24" Cottonwood
S 10 W 84.92' Set 60d Nail/Remon Tag #33138 West face 36" Silver Maple
N 15 E 22.35' Chisel X South top of Southerly Boulder (cluster of 3-4 large rocks)
East 54.11' K-1, T3N, R8E, Concrete monument w/Remon Cap #33138

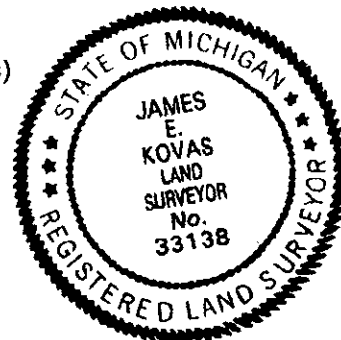

Signed by James E. Kovas Date 9/10/98

Surveyor's Michigan License No. 33138

100-29829012

700 FILE
200