SURVEY & REMONUMENTATION

MAY - 1 1995

COMMISSION

LIBER 15235 PG 086

FEB 29 5020302

$ 7.00 MISCELLANEOUS RECORDING
$ 2.00 REMONUMENTATION
02 FEB 95 9:42 A.M. RECEIPT# 508
PAID RECORDED - OAKLAND COUNTY
LYNN D. ALLEN, CLERK/REGISTER OF DEEDS

LAND CORNER RECORDATION CERTIFICATE

Filing Requirement of Act 74, Mich. P.A. 1970

For corners in Oakland (County)

	Located In:	Corner Code ##
1. Public Land Survey	T 4N R 9E	H-11
	T ___ R ___	
	T ___ R ___	
	T ___ R ___	
2. Property Controlling	S ___ T ___ R ___	
in Section	S ___ T ___ R ___	
3. Miscellaneous	S ___ T ___ R ___	
Property in Sec.	S ___ T ___ R ___	

OK - T. SMITH

Compliance with ACT 345, P.A. 1990

APPROVED ON: 1-25-95
OAKLAND COUNTY REMONUMENTATION PEER GROUP COMMITTEE

Register of Deeds Stamp & File Number

4. Lot No. _____, Recorded Plat _____
5. Private Claims _____

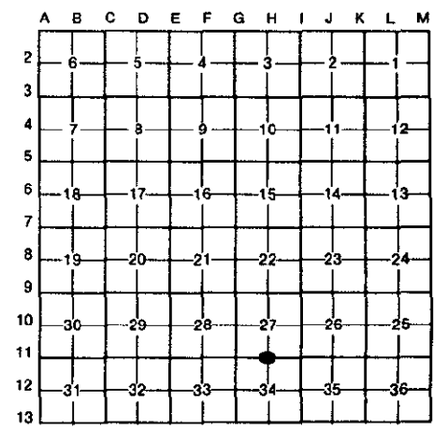

I, James J. Scharl, in a field survey on December 19, 19 94, do hereby certify that under requirements of P.A. 74, Michigan P.A. of 1970, the corner points mentioned in lines 1 and 2 above were in conformance with regulations and rules therefore as required in the current manual of survey instructions of the United States Department of the Interior, Bureau of Land Management or by a decree of a Court of Law and/or that the corner points mentioned in lines 3, 4 and 5 above were in conformance with the rules of the Michigan Board of Land Surveyors or by a Decree of a Court of Law; established, re-established, monumented, re-monumented, recovered, found as expressed below:

NOTE: Not more than 4 corners, all in the same town and range, may be recorded on this certificate.

A. Description of original monument and accessories and/or subsequent restoration:

Post set in 1817, G.L.O. survey; N74°W 27 lks, 12" B Oak; N71°E 54 lks, 9" B Oak.

LCRC, L5974, P622	LCRC, L6634, P222	LCRC, L11932, P817-8	LCRC, L14483, P094
F. Jones, 1972	Heil, 1976	Stonerock, 1991	LCRC, L14645, P003
1" iron	Iron pipe in well	1/2" IP in mon box	PK at center intersection
N60°W 73.58' DE pole	NW 73.30' nail in pole	N45°W 73.21 N/C PP	N45°W 73.22' PK/wash. pole
S40°E 45.25' DE pole	NE 49.30' iron post in conc base	N47°E 46.76 N/C guy pole	N40°E 55.13' to S corner catchbasin
N80°W 81.25' DE pole	SE 45.30' nail in pole	S46°E 45.30' N/C PP	S45°W 73.63' PK/wash. pole
		S44°W 73.61' N/C PP	*S45°E 75.99' PK/wash. pole

B. Description of corner evidence found and/or method applied in restoring or reestablishing corner:

Recovered a 1/2" iron pipe in a monument box located at the centerline intersection of Sashabaw and Maybee Roads.

Witnesses Found
*S45°E 75.99' PK/tag SE face DE pole
S45°E 92.54' PK/tag SE face DE pole
N40°E 62.18' most S'ly corner catchbasin

STATE OF MICHIGAN
JAMES J. SCHARL
PROFESSIONAL SURVEYOR
NO. 19843
LICENSED LAND SURVEYOR

*Confirms LCRC witness

C. Description of monument for corner and accessories established to perpetuate locating the position of the corner:

Set 5/8" rerod with Oakland County remonumentation brass cap in monument box, replacing 1/2" iron pipe.
N 45°W 71.40' PK/remon tag SE corner signal light base
N 45°E 63.64' PK/remon tag NW side crosswalk sign post
S 45°E 75.97' PK/remon tag SW face DE pole
S 45°W 92.56' PK/remon tag SE face DE pole

The selected location is accepted by the Contractor and is generally accepted by professional surveyors as the best available evidence of the position of the original corner. This corner was also acceptd by the Oakland County Peer Group as established under Act 345 of P.A. 1990.

Signed by James J. Scharl Date December 28, 1994

Surveyor's Michigan License No. 19843

FORM APPROVED BY MICHIGAN STATE BOARD OF LAND SURVEYORS, JAN. 28, 1971
REVISED MAY 14, 1975
REVISED JAN., 1983