

MAY - 1 1995

LAND CORNER RECORDATION CERTIFICATE

For corners in

COMMISSION

Filing Requirement of Act 74, Mich. P.A. 1970

\$ 7.00 MISCELLANEOUS RECORDING
\$ 2.00 REMONUMENTATION
2 FEB 95 9:43 A.M. RECEIPT# 50B
PAID RECORDED - OAKLAND COUNTY
LYNN D. ALLEN, CLERK/REGISTER OF DEEDS

Table with columns: OakLand (County), Located In:, Corner Code #, and rows for Public Land Survey, Property Controlling in Section, and Miscellaneous Property in Sec.


OK - T. SMITH

Compliance with ACT 345, P.A. 1990

APPROVED ON: 1-25-95
OAKLAND COUNTY REMONUMENTATION PEER GROUP COMMITTEE
Register of Deeds Stamp & File Number

- 4. Lot No.
5. Private Claims

I, James J. Scharl, in a field survey on December 16, 1994, do hereby certify that under requirements of P.A. 74, Michigan P.A. of 1970, the corner points mentioned in lines 1 and 2 above were in conformance with regulations and rules therefore as required in the current manual of survey instructions of the United States Department of the Interior, Bureau of Land Management or by a decree of a Court of Law and/or that the corner points mentioned in lines 3, 4 and 5 above were in conformance with the rules of the Michigan Board of Land Surveyors or by a Decree of a Court of Law; established, re-established, monumented, re-monumented, recovered, found as expressed below:

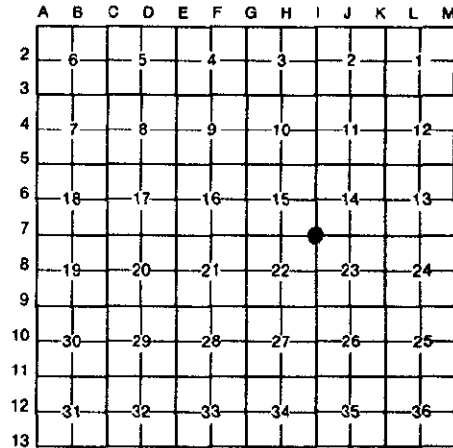

NOTE: Not more than 4 corners, all in the same town and range, may be recorded on this certificate.

A. Description of original monument and accessories and/or subsequent restoration:

- 24" Oak stands at corner in 1817 G.L.O. survey.
LCRC, L108691, P248 Kennedy, 1989 Found 1/2" iron rod
LCRC, L14494, P032 Scharl, 1994 Found 1/2" iron
*N 80°W 20.05' PK/wash. S face 11" Oak
*N 10°E 50.94' PK/wash. W face 20" Oak
S 85°E 22.08' PK/wash. N face 16" Oak
*N 25°E 51.00' PK/tag #17623 twin oaks
S 60°E 22.04' PK/tag #17623 14" Oak
*N 60°W 20.01' IK/tag #17623 12" Oak
*S 35°W 43.09' PK/tag #17623 twin 10" Hickory

Handwritten notes: 200, 200, file

B. Description of corner evidence found and/or method applied in restoring or reestablishing corner:

Recovered 1/2" rerod below the gravel road surface on the centerline of Pine Knob Road. Tree lines run east and west from the corner. A 3/4" iron pipe was also recovered, West 3.40 ft, from the 1/2" rerod, but was disregarded through lack of supporting evidence.

Witnesses Found

- *N80°W 20.05' PK tag #17623 S face 12" Oak
N80°W 20.06' PK tag #22445 S face 12" Oak
*S35°W 43.07' PK SE face twin 10" Hickory
*N25°E 51.02' PK tag #17623 W face twin 15" Oak
N25°E 50.51' PK tag #22445 W face twin 15" Oak
N25°E 50.51' PK W face twin 15" Oak
S60°E 22.18' PK tag #22445 SW face 14" Oak

*Confirms LCRC witnesses



C. Description of monument for corner and accessories established to perpetuate locating the position of the corner:

- Set 5/8" rerod with Oakland County remonumentation brass cap, replacing 1/2" rerod.
S 35°W 43.08' PK/remontag SE face twin 10" Hickory
N 30°W 36.18' PK/remontag NE face triple 14" Oak
N 25°E 50.54' PK/remontag W face twin 14" Oak
S 60°E 22.21' PK/remontag S face 14" Oak

The selected location is accepted by the Contractor and is generally accepted by professional surveyors as the best available evidence of the position of the original corner. This corner was also accepted by the Oakland County Peer Group as established under Act 345 of P.A. 1990.

Signed by James J. Scharl Date Dec. 28, 1994
Surveyor's Michigan License No. 19843