

SURVEY & REMONUMENTATION

MAY - 1 1995

LIBER 15235 PG 092

FEB 295020308

COMMISSION

LAND CORNER RECORDATION CERTIFICATE \$ 7.00 MISCELLANEOUS RECORDING
 Filing Requirement of Act 74, Mich. P.A. 1970 \$ 2.00 REMONUMENTATION

For corners in

2 FEB 95 9:43 A.M. RECEIPT# 508
 PAID RECORDED - OAKLAND COUNTY
 LYNN D. ALLEN, CLERK/REGISTER OF DEEDS

Oakland (County)	Located In:	Corner Code #
1. Public Land Survey	T 4N R 9E	I-9
	T R	
	T R	
	T R	
2. Property Controlling in Section	S T R	
	S T R	
3. Miscellaneous Property in Sec.	S T R	
	S T R	


OK - T. SMITH

Compliance with ACT 345, P.A. 1990

APPROVED ON: 1-25-95
 OAKLAND COUNTY REMONUMENTATION PEER GROUP COMMITTEE
 Register of Deeds Stamp & File Number

4. Lot No. _____, Recorded Plat _____
 5. Private Claims _____

I, James J. Scharl, in a field survey on December 16, 19 94, do hereby certify that under requirements of P.A. 74, Michigan P.A. of 1970, the corner points mentioned in lines 1 and 2 above were in conformance with regulations and rules therefore as required in the current manual of survey instructions of the United States Department of the Interior, Bureau of Land Management or by a decree of a Court of Law and/or that the corner points mentioned in lines 3, 4 and 5 above were in conformance with the rules of the Michigan Board of Land Surveyors or by a Decree of a Court of Law, established, re-established, monumented, re-monumented, recovered, found as expressed below:

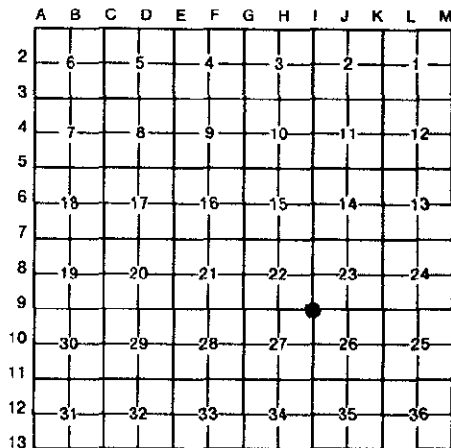

NOTE: Not more than 4 corners, all in the same town and range, may be recorded on this certificate.

- A. Description of original monument and accessories and/or subsequent restoration:
- | | | |
|--|---------------------------------|---------------------------------|
| Post set in 1817 G.L.O. Survey; S74°E 86 lks, 12" B Oak; N53°W 94 lks, 14" W Oak | LCRC, L7831, P321 | LCRC, L11066, P503 |
| O.C.R.C., 1963 | Davis, 1980 | Gorman, 1989 |
| M.S.H.D., 1958 | Found 1/2" rod | Reset 5/8" rod/cap |
| Found 1/2" rod | *N08°W 22.01' double 8" Oak | *N10°W 22.31' PK twin 13" Oak |
| *N08°W 22.01' double 8" Oak | *N72°E 46.34' 14" Oak | *N72°E 46.40' PK 14" Oak |
| *N72°E 46.41' 13" Oak | S53°W 29.37' PK 14" Maple | S53°W 29.37' PK 15" Oak |
| S53°W 30.18' 10" Oak | S80°E 107.75' PK 10" quad Maple | S80°E 107.75' PK 10" quad Maple |
| MSHD 1958, cor H-9 | *West 2632.38' 1/2" in mon box | *West 2632.38' 1/2" in mon box |
- *East 2633.07' SE.22

B. Description of corner evidence found and/or method applied in restoring or reestablishing corner:
 Recovered 1/2" rered with M.D.O.T. cap, 3 feet north of the centerline of Waldon Road.
 A tree line runs north from the corner.

Witnesses Found
 *N 10°W 22.31' PK W face twin 14" Oak
 *N 72°E 46.25' PK S face 14" stump Oak
 *West 2632.65' 5/8" rered in mon box



*Confirms LCRC witness

- C. Description of monument for corner and accessories established to perpetuate locating the position of the corner:
 Set 5/8" rered with Oakland County remonumentation brass cap, replacing 5/8" rod.
 N 10°W 22.19' PK/remon tag W face twin 14" Oak
 S 45°W 30.25' PK/remon tag E face 16" Oak
 S 45°E 31.97' PK/remon tag W face 18" Oak
 N 50°E 40.19' PK/remon NW face 10" Cherry

The selected location is accepted by the Contractor and is generally accepted by professional surveyors as the best available evidence of the position of the original corner. This corner was also accepted by the Oakland County Peer Group as established under Act 345 of P.A. 1990.

Signed by James J. Scharl Date Dec. 28, 1994
 Surveyor's Michigan License No. 19843