

SURVEY &  
REMONUMENTATION

LISCR 15235 PC 094

FEB 295020310

MAY - 1 1995

LAND CORNER RECORDATION CERTIFICATE \$ 7.00 MISCELLANEOUS RECORDING  
Filing Requirement of Act 74, Mich. P.A. 1970 \$ 2.00 REMONUMENTATION

For corners in

Oakland  
(County)

COMMISSION

Located In:

Corner Code #

- |                                    |   |    |   |    |     |
|------------------------------------|---|----|---|----|-----|
| 1. Public Land Survey              | T | 4N | R | 9E | J-3 |
|                                    | T |    | R |    |     |
|                                    | T |    | R |    |     |
|                                    | T |    | R |    |     |
| 2. Property Controlling in Section | S |    | T | R  |     |
|                                    | S |    | T | R  |     |
| 3. Miscellaneous Property in Sec.  | S |    | T | R  |     |
|                                    | S |    | T | R  |     |

2 FEB 95 9:44 A.M. RECEIPT# 50B  
PAID RECORDED - OAKLAND COUNTY  
LYNN D. ALLEN, CLERK/REGISTER OF DEEDS

OK - T. SMITH


Compliance with  
ACT 345, P.A. 1990

APPROVED ON: 1-25-95  
OAKLAND COUNTY REMONUMENTATION  
PEER GROUP COMMITTEE  
Register of Deeds Stamp & File Number

4. Lot No. \_\_\_\_\_, Recorded Plat \_\_\_\_\_  
5. Private Claims \_\_\_\_\_

I, James J. Scharl, in a field survey on December 16, 19 94, do hereby certify that under requirements of P.A. 74, Michigan P.A. of 1970, the corner points mentioned in lines 1 and 2 above were in conformance with regulations and rules therefore as required in the current manual of survey instructions of the United States Department of the Interior, Bureau of Land Management or by a decree of a Court of Law and/or that the corner points mentioned in lines 3, 4 and 5 above were in conformance with the rules of the Michigan Board of Land Surveyors or by a Decree of a Court of Law; established, re-established, monumented, re-monumented, recovered, found as expressed below:

**NOTE: Not more than 4 corners, all in the same town and range, may be recorded on this certificate.**

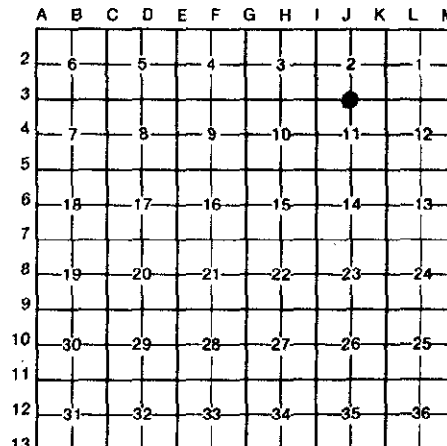

A. Description of original monument and accessories and/or subsequent restoration:

Post set in 1817 G.L.O. survey; N 83°W 14 lks, 6" W Oak;	S 80°E 66 lks, 9" W Oak.
LCRC, L6381, P660	LCRC, L6212, P270
Jones, 1973	Stonerock, 1973
Found pinch top iron	Found pinch top pipe
North 39.25' nail W side 16" Oak	*N 10°E 35.50' PK/cap 10" Hickory
*N 30°E 37.19' nail E side 20" Oak	S 70°E 36.80' PK/cap 12" Oak
S 45°E 36.16' nail S side 10" Oak	

B. Description of corner evidence found and/or method applied in restoring or reestablishing corner:

Recovered pinch top pipe 6 feet south of centerline of Whipple Lake Road. A fence/tree line runs north from the corner.

Witnesses Found

\*N 10°E 35.40' PK/tag E face 14" Hickory  
\*N 30°E 36.84' nail/tag E face 20" Oak  
S 70°E 35.35' PK/tag 18" Oak

\*Confirms LCRC witness



C. Description of monument for corner and accessories established to perpetuate locating the position of the corner:

Set 5/8" rerod with Oakland County Remonumentation brass cap, replacing pinch top pipe.

N 10°E 35.33' PK/remon tag E face 14" Hickory  
N 30°E 36.85' PK/remon tag E face 20" Oak  
S 70°E 36.25' PK/remon tag N face 18" Oak  
S 20°W 79.08' PK/remon tag W face DE pole

The selected location is accepted by the Contractor and is generally accepted by professional surveyors as the best available evidence of the position of the original corner. This corner was also accepted by the Oakland County Peer Group as established under Act 345 of P.A. 1990.

Signed by

*James J. Scharl*

Date Dec. 28, 1994

Surveyor's Michigan License No.

19843