

MAY 16 1996

LAND CORNER RECORDATION CERTIFICATE

\$ 7.00 MISCELLANEOUS RECORDING

\$ 2.00 REMONUMENTATION

RECEIPT# 14B PAID RECORDED - OAKLAND COUNTY LYNN D. ALLEN, CLERK/REGISTER OF DEEDS

For corners in

COMMISSION

Filing Requirement of Act 74, Mich. P.A. 1970

Form with fields for County (Oakland), Located In, Corner Code #, and numbered sections 1-5 for survey details.

Compliance with ACT 345, P.A. 1990. APPROVED ON: 2-15-95 OAKLAND COUNTY REMONUMENTATION PEER GROUP COMMITTEE Register of Deeds Stamp & File Number

I, James J. Scharl, in a field survey on December 12, 1994, do hereby certify that under requirements of P.A. 74, Michigan P.A. of 1970, the corner points mentioned in lines 1 and 2 above were in conformance with regulations and rules therefore as required in the current manual of survey instructions of the United States Department of the Interior, Bureau of Land Management or by a decree of a Court of Law and/or that the corner points mentioned in lines 3, 4 and 5 above were in conformance with the rules of the Michigan Board of Land Surveyors or by a Decree of a Court of Law; established, re-established, monumented, re-monumented, recovered, found as expressed below:

Grid table with columns A-M and rows 2-13, containing numerical values for survey points.

NOTE: Not more than 4 corners, all in the same town and range, may be recorded on this certificate.

A. Description of original monument and accessories and/or subsequent restoration: Post set in 1817 G.L.O. survey; S 23°E 44 lks, 10" W Oak; N 20°W 65 lks, 12" W Oak. LCRC, L7717, P610; LCRC, L7288, P542; LCRC, L8160, P519. Jones, 1978; Kennedy, 1978; Hubbell, 1981. Found 3/4" iron; Found 1/2" iron rod; Found 3/4" rerod. *N45°E 36.80' N/W SE 14" Walnut; *S60°E 45.41' N/W NE 38" Oak.


B. Description of corner evidence found and/or method applied in restoring or reestablishing corner: Recovered 3/4" bar 3 feet east of centerline of Dartmouth Road on the centerline of Indianwood Road.

Witnesses Found: *N 45°E 36.66' PK/W #17623 SE face 18" Walnut; *S 60°E 45.48' PK/W #17623 SW face 40" Oak; S 60°E 44.88 PK/W SW face 40" Oak; S 70°W 41.03' PK/W N face 18" Cherry; N 60°W 64.32' PK/W #17623 NE face MBT pole; N 60°W 64.34' PK/W NE face MBT pole.

*Confirms LCRC witness

C. Description of monument for corner and accessories established to perpetuate locating the position of the corner: Set 5/8" rerod with O.C. remonumentation brass cap, replacing 3/4" bar. N 45°E 36.59' PK/remon tag SE face 18" Walnut; S 60°E 45.46' PK/remon tag SW face 40" Oak; S 45°W 63.13' PK/remon tag S face DE pole; N 60°W 64.46' PK/remon SW face DE pole.

The selected location is accepted by the Contractor and is generally accepted by professional surveyors as the best available evidence of the position of the original corner. This corner was also accepted by the Oakland County Peer Group as established under Act 345 of P.A. 1990.

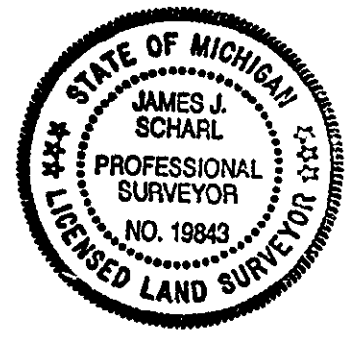

Signed by James J. Scharl Date February 6, 1995 Surveyor's Michigan License No. 19843