

LAND CORNER RECORDATION CERTIFICATE
Filing Requirement of Act 74, Mich. P.A. 1970

For corners in Oakland Located In: _____ Corner Code # _____
(County)

1. Public Land Survey T 4N R 9E _____ K-4
T _____ R _____
T _____ R _____
T _____ R _____

2. Property Controlling S _____ T _____ R _____
in Section S _____ T _____ R _____

3. Miscellaneous S _____ T _____ R _____
Property in Section S _____ T _____ R _____

4. Lot No. _____, Recorded Plat _____

5. Private Claims _____


Compliance with
ACT 345, P.A. 1990

APPROVED ON: 9-27-95 Tom S

OAKLAND COUNTY REMONUMENTATION
PEER GROUP COMMITTEE

Register of Deeds Stamp & File Number

I, James J. Scharl, in a field survey on 8-21, 19 95, do hereby certify that under requirements of P.A. 74, Michigan P.A. of 1970, the corner points mentioned in lines 1 and 2 above were in conformance with regulations and rules therefore as required in the current manual of survey instructions of the United States Department of the Interior, Bureau of Land Management or by a decree of a Court of Law and/or that the corner points mentioned in lines 3, 4 and 5 above were in conformance with the rules of the Michigan Board of Professional Surveyors or by a Decree of a Court of Law; established, re-established, monumented, re-monumented, recovered, found as expressed below:

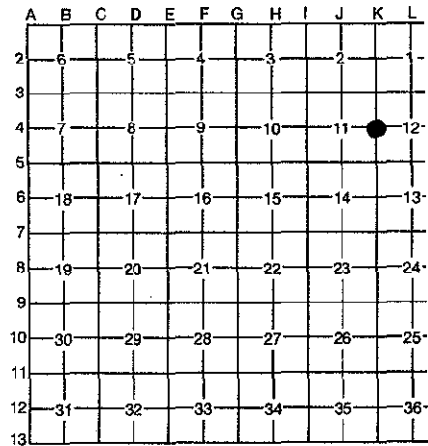

NOTE: Not more than 4 corners, all in the same town and range, may be recorded on this certificate.

A. Description of original monument and accessories and/or subsequent restoration:


Post set in 1817 G.L.O. survey

S 79°E 7 lks 11" Aspen
S 57°W 59 lks 5" B. Oak

\$ 7.00 MISCELLANEOUS RECORDING
\$ 2.00 REMONUMENTATION
29 SEP 95 7:30 A.M. RECEIPT# 5B
PAID RECORDED - OAKLAND COUNTY
LYNN D. ALLEN, CLERK/REGISTER OF DEEDS

B. Description of corner evidence found and/or method applied in restoring or reestablishing corner:

Corner was not recovered. The location of the corner was determined to be lost. The corner was set at the midpoint distance (2646.145 ft) on line between the SE and NE corners of Section 11.

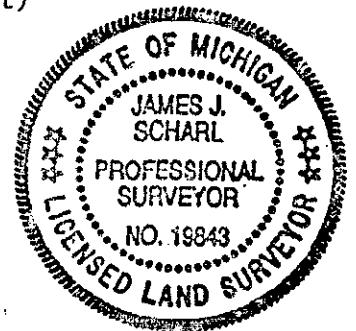

C. Description of monument for corner and accessories established to perpetuate locating the position of the corner:

Set PK nail in wood deck of House #8925 Minne Wana Road.

N 45°W 12.91' NE corner house #8925
S 15°E 18.65' SE corner House #8925
S 45°E 9.65' PK/remon tag NE face 16" oak
East 31.25' PK/remon tag N face 14" Oak

The selected location is a careful and faithful reestablishment of the position of the original corner. This corner was also accepted by the Oakland County Peer Group as established under Act 345 of P.A. 1990.

Signed by James J. Scharl
Surveyor's Michigan License No. 19843

Date Sept. 26, 1995

7.00
2.00
RW