

LAND CORNER RECORDATION CERTIFICATE

Filing Requirement of Act 74, Mich. P.A. 1970

\$ 7.00 MISCELLANEOUS RECORDING

\$ 2.00 REMONUMENTATION

29 SEP 95 7:30 A.M. RECEIPT# 58 PAID RECORDED - OAKLAND COUNTY LYNN D. ALLEN, CLERK/REGISTER OF DEEDS

For corners in

Oakland (County)

Located In:

Corner Code #

- 1. Public Land Survey T 4N R 9E K-11
2. Property Controlling in Section S T R
3. Miscellaneous Property in Sec. S T R

Compliance with ACT 345, P.A. 1990

APPROVED ON: 9-27-95 JMS OAKLAND COUNTY REMONUMENTATION PEER GROUP COMMITTEE Register of Deeds Stamp & File Number


- 4. Lot No. Recorded Plat
5. Private Claims

I, James J. Scharl, in a field survey on 8-12, 19 95, do hereby certify that under requirements of P.A. 74, Michigan P.A. of 1970, the corner points mentioned in lines 1 and 2 above were in conformance with regulations and rules therefore as required in the current manual of survey instructions of the United States Department of the Interior...

NOTE: Not more than 4 corners, all in the same town and range, may be recorded on this certificate.

Grid table with columns A-M and rows 2-13. A dot is marked at the intersection of column J and row 11.

- A. Description of original monument and accessories and/or subsequent restoration: Post set in 1817 G.L.O. survey; N 17°E 25 lks 12" B. oak; S 64°W 62 lks 24" W. oak
B. Description of corner evidence found and/or method applied in restoring or reestablishing corner: Recovered PK nail 2.95' north of existing 1/2" rerod in monument box.

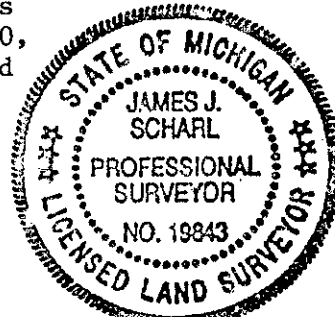

Witnesses Found *N 20°E 80.08' Consumers Power marker *N 45°W 112.60' PK & tag 18" poplar *South 2666.15' to E 1/4 Sec. 35

- *Confirms LCRC's
C. Description of monument for corner and accessories established to perpetuate locating the position of the corner: Set 5/8" rerod with O.C. remonumentation brass cap in monument box, replacing PK nail.

The selected location is accepted by the Contractor and is generally accepted by professional surveyors as the best available evidence of the position of the original corner. This corner was also accepted by the Oakland County Peer Group as established under Act 345 of P.A. 1990.

Signed by James J. Scharl Date August 28, 1995 Surveyor's Michigan License No. 19843