## LIBER 15305 pt 858

MAY 1. 6 1995

## LAND CORNER RECORDATION CERTIFICATE Filing Requirement of Act 74, Mich. P.A. 1970



| For | comers | in CO | MANA   | 55       | ON  |
|-----|--------|-------|--------|----------|-----|
| ror | comers | meaca | EALIAN | $\omega$ | 100 |

Oalel and


| Vakianu |                      | Located in: | Corner Code ## |  |  |
|---------|----------------------|-------------|----------------|--|--|
|         | (County)             | •           |                |  |  |
| 1.      | Public Land Survey   | T 4N R 9E   | L-11           |  |  |
|         |                      | T R         |                |  |  |
|         |                      | T R         |                |  |  |
|         |                      | T R         |                |  |  |
| 2.      | Property Controlling | S T R       |                |  |  |
|         | in Section           | S T R       |                |  |  |
| 3.      | Miscellaneous        | S T R       |                |  |  |
|         | Property in Sec.     | S T R       |                |  |  |
|         |                      |             |                |  |  |


\$ 7.00 KISCELLANEOUS RECORDING


\$ 2.00 REMONUMENTATION 23 MAR 95 9:50 A.N. RECEIPT# 14B RECORDED - DAKLAND COUNTY PATN LYNN D. ALLEN, CLERK/REGISTER OF DEEDS Compliance with ACT 345, P.A. 1990

2-15-95 APPROVED ON: OAKLAND COUNTY REMONUMENTATION PEER GROUP COMMITTEE Register of Deeds Stamp & File Number

| 4. | Lot No,        | Recorded | Plat |
|----|----------------|----------|------|
| 5  | Private Claims |          |      |

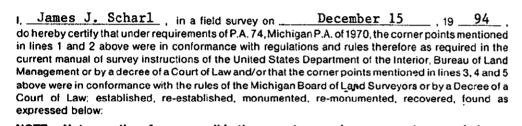

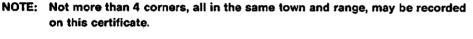

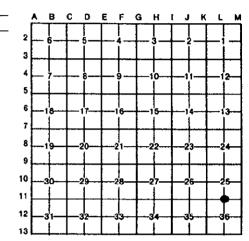

A. Description of original monument and accessories and/or subsequent restoration:

Post set in 1817 G.L.O. survey; S 42°E 22 1ks, 10" W Walnut; N 17°E 24 1ks, 10" W Oak. LCRC, L12408, P671

Stonerock, 1992, found 1/2" I.P.

\*N 60°E 40.46' N/C NW face 12" Oak

\*S 60°E 30.31' N/C N face 12" Poplar

8.46' N/C E face 14" Ash \*South

\*S 45°W 32.72' N/C N face 12" Ash

B. Description of corner evidence found and/or method applied in restoring or reestablishing corner: Recovered 1/2" pipe off the road surface of Maybee Road located on the centerline extension from the west and 30 ft west of the centerline extension from the north. A tree line extends north from the corner. A 1/2" rerod was found 4.2' south of the 1/2" pipe, but its position was rejected due to lack of supporting record and field evidence.

| Wit | nesse | s Found |
|-----|-------|---------|
| N   | 60°E  | 40.62   |

Surveyor's Michigan License No. .

PK/tag 12" Ash \*N 65°E 40.47' PK/tag 12" Oak

\*S 60°E 30.31' PK/tag 12" Poplar

8.48' PK/tag Twin 12" Ash 28.69' PK/tag 12" Elm \*South

S 70°W

\*S 75°W 32.79' PK/tag 10" Ash



\*Confirms LCRC witness C. Description of monument for corner and accessories established to perpetuate locating the position of the corner:

Set concrete monument with O.C. remonumentation brass cap.

N 60°E 40.52' PK/remon tag SW face 12" Ash

30.31' PK/remon tag N face 12" Poplar S 60°E

8.66' PK/remon tag E face Twin Ash 32.82' PK/remon N face 10" Ash South

S 75°W

The selected location is accepted by the Contractor and is generally accepted by professional surveyors as the best available evidence of the position of the original corner. This corner was also accepted by the Oakland County Peer Group as established under Act 345 of P.A. 1990.

| (Signed by |            | (ame) |        | , S Darl | Date | February 8, | 1995 |
|------------|------------|-------|--------|----------|------|-------------|------|
| •          | <b>1</b> . | ] .   | (0010) | 1        |      |             |      |

FORM APPROVED BY MICHIGAN STATE BOARD OF LAND SURVEYORS, JAN. 26, 1975 REVISED MAY 14, 1975 REVISED JAN., 1983

