

LAND CORNER RECORDATION CERTIFICATE
Filing Requirement of Act 74, Mich. P.A. 1970

For corners in

Table with columns: Oakland (County), Located In, Corner Code. Rows include Public Land Survey, Property Controlling in Section, and Miscellaneous Property in Sec.

Compliance with ACT 345, P.A. 1990
APPROVED ON: 9-27-95 JMS
OAKLAND COUNTY REMONUMENTATION PEER GROUP COMMITTEE
Register of Deeds Stamp & File Number

4. Lot No. , Recorded Plat
5. Private Claims

I, James J. Scharl, in a field survey on 8-9, 19 95, do hereby certify that under requirements of P.A. 74, Michigan P.A. of 1970, the corner points mentioned in lines 1 and 2 above were in conformance with regulations and rules therefore as required in the current manual of survey instructions of the United States Department of the Interior, Bureau of Land Management or by a decree of a Court of Law and/or that the corner points mentioned in lines 3, 4 and 5 above were in conformance with the rules of the Michigan Board of Land Surveyors or by a Decree of a Court of Law; established, re-established, monumented, re-monumented, recovered, found as expressed below:


Grid table with columns A-M and rows 2-13. A dot is marked at the intersection of column J and row 5.

NOTE: Not more than 4 corners, all in the same town and range, may be recorded on this certificate.

A. Description of original monument and accessories and/or subsequent restoration:
Post set in 1817 G.L.O. survey
9" R. oak N 55°E 46 lks
18" W. oak South 8 lks

\$ 7.00 MISCELLANEOUS RECORDING
\$ 2.00 REMONUMENTATION
29 SEP 95 7:30 A.M. RECEIPT# 5B
PAID RECORDED - OAKLAND COUNTY
LYNN D. ALLEN, CLERK/REGISTER OF DEEDS

B. Description of corner evidence found and/or method applied in restoring or reestablishing corner:
Recovered 3/8" rerod on side of hill. There are no occupation lines running from the corner. Corner confirmed with monumentation found in the "Thendara Park Country Club" subdivision recorded in L 38, P 40, O.C. Records, and survey west of subdivision by Kieft Engineering.

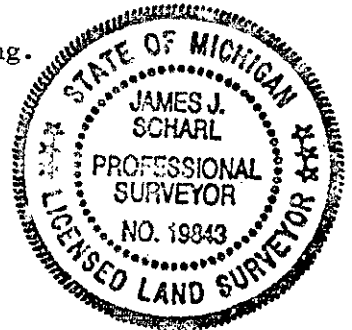

C. Description of monument for corner and accessories established to perpetuate locating the position of the corner:
Set concrete monument with remonumentation brass cap, replacing 3/8" rerod.
N 35°E 17.65' PK/remon tag SW face 14" hickory
N 10°E 7.92' PK/remon tag SE face 16" ash
S 89°E 14.34' PK/remon tag S face 12" ash
S 10°E 8.31' PK/remon tag SW face 18" oak

Handwritten notes: 7.00, 2.00, Rm

The selected location is accepted by the Contractor and is generally accepted by professional surveyors as the best available evidence of the position of the original corner. This corner was also accepted by the Oakland County Peer Group as established under Act 345 of P.A. 1990.

Signed by [Signature] Date August 28, 1995
Surveyor's Michigan License No. 19843