

LAND CORNER RECORDATION CERTIFICATE

Filing Requirement of Act 74, Mich. P.A. 1970

\$ 7.00 MISCELLANEOUS RECORDING

\$ 2.00 REMONUMENTATION

For corners in Oakland (County)

Located In:

Corner Code #

29 SEP 95 7:28 A.M. RECEIPT# 5B PAID RECORDED - OAKLAND COUNTY LYNN D. ALLEN, CLERK/REGISTER OF DEEDS

Compliance with ACT 345, P.A. 1990

APPROVED ON: 9-27-95 JMS OAKLAND COUNTY REMONUMENTATION PEER GROUP COMMITTEE

Register of Deeds Stamp & File Number

Table with 3 columns: Item description, Corner Code (T/S), and Range/Section (e.g., 4N R 10E). Includes items like Public Land Survey, Property Controlling in Section, and Miscellaneous Property in Section.

4. Lot No. , Recorded Plat Private Claims

I, James J. Scharl, in a field survey on 8-10, 19 95, do hereby certify that under requirements of P.A. 74, Michigan P.A. of 1970, the corner points mentioned in lines 1 and 2 above were in conformance with regulations and rules therefore as required in the current manual of survey instructions of the United States Department of the Interior, Bureau of Land Management or by a decree of a Court of Law and/or that the corner points mentioned in lines 3, 4 and 5 above were in conformance with the rules of the Michigan Board of Professional Surveyors or by a Decree of a Court of Law; established, re-established, monumented, re-monumented, recovered, found as expressed below:

NOTE: Not more than 4 corners, all in the same town and range, may be recorded on this certificate.

A. Description of original monument and accessories and/or subsequent restoration:

1817 G.L.O. survey F.A. Slater, County LCRC, L 7041, P 341
Intersect range line Surveyor 1902 Henderson, 1974
North *184.80' of Independence Twp corner South *185.46' to SE corner Sec. 13, T4N, R9E 1/2" iron pipe fd
N 37°E 25 lks 18" Ash *N 45°E 6.70' 6" Poplar
S 48°E 17 lks 11" Beech E.S. Harger, County *N 05°W 41.0' 8" Poplar
Surveyor 1922 *S 80°E 26.26' 8" Poplar
South *187.0' to SE corner Sec. 13, T4N, R9E

B. Description of corner evidence found and/or method applied in restoring or reestablishing corner:

Recovered concrete monument at intersection of north, south and east tree/fence/rock rows.

Witnesses Found

*N 45°E 6.70' 6" Poplar
*N 05°W 41.0' 8" Poplar
*S 80°E 26.26' 8" Poplar
*South 188.05' Conc. monument

*Confirms survey or LCRC

C. Description of monument for corner and accessories established to perpetuate locating the position of the corner:

Set O.C. remonumentation brass cap on recovered conc. monument.


N 45°W 14.67' PK/remon tag S face 14" Ash
S 40°W 11.25' PK/remon tag NW face 8" Elm
S 10°E 21.94' PK/remon tag W face 10" Poplar
East 11.68' PK/remon tag N face 8" Elm

The selected location is accepted by the Contractor and is generally accepted by professional surveyors as the best available evidence of the position of the original corner. This corner was also accepted by the Oakland County Peer Group as established under Act 345 of P.A. 1990

Signed by James J. Scharl Surveyor's Michigan License No. 19843

Date September 18, 1995

Grid table with columns A-L and rows 2-13. Contains numerical values in some cells, likely representing a survey grid or coordinate system.

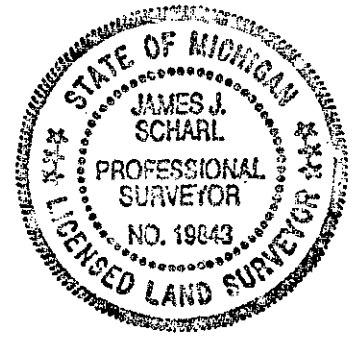

Handwritten notes: 7.0, 2.0, P1