

SEP 29 1995 188799

15709-008

LAND CORNER RECORDATION CERTIFICATE
Filing Requirement of Act 74, Mich. P.A. 1970

For corners in Oakland (County)

Located In:

Corner Code #

- 1. Public Land Survey T 4N R 10E A-8
2. Property Controlling in Section S T R
3. Miscellaneous Property in Section S T R

Compliance with ACT 345, P.A. 1990

APPROVED ON: 9-27-95 Tom J. OAKLAND COUNTY REMONUMENTATION PEER GROUP COMMITTEE

Register of Deeds Stamp & File Number

- 4. Lot No. , Recorded Plat
5. Private Claims

I, James J. Scharl, in a field survey on 8-10, 19 95, do hereby certify that under requirements of P.A. 74, Michigan P.A. of 1970, the corner points mentioned in lines 1 and 2 above were in conformance with regulations and rules therefore as required in the current manual of survey instructions of the United States Department of the Interior, Bureau of Land Management or by a decree of a Court of Law and/or that the corner points mentioned in lines 3, 4 and 5 above were in conformance with the rules of the Michigan Board of Professional Surveyors or by a Decree of a Court of Law; established, re-established, monumented, re-monumented, recovered, found as expressed below:

Grid table with columns A-L and rows 1-13. Cell (8,8) is shaded.

NOTE: Not more than 4 corners, all in the same town and range, may be recorded on this certificate.


A. Description of original monument and accessories and/or subsequent restoration:

This corner was not set in the 1817 G.L.O. survey.

\$ 7.00 MISCELLANEOUS RECORDING
\$ 2.00 REMONUMENTATION
29 SEP 95 7:28 A.M. RECEIPT# 58
PAID RECORDED - OAKLAND COUNTY
LYNN D. ALLEN, CLERK/REGISTER OF DEEDS

B. Description of corner evidence found and/or method applied in restoring or reestablishing corner:

Recovered a 1/2" rered with cap #17632. No occupation lines run from this corner. The corner is referended by a 1989 survey by Wozniak of Sec. 24, T4N, R9E, and the W 1/2 of Sec. 19, T4N, R10E. Giffels and Webster #17632 set the corner from the information on the Wozniak survey. Measurements confirm the capped rered with the record survey.

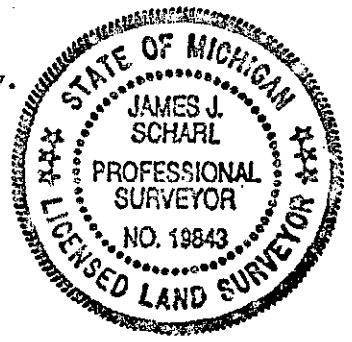

C. Description of monument for corner and accessories established to perpetuate locating the position of the corner:

Set 5/8" rered with O.C. remonumentation brass cap in root of 50" willow tree, replacing 1/2" capped rered.

- N 80°W 9.80' PK/remon tag S face 6" Ash
N 40°E 24.45' PK/remon tag SE face 8" Ash
South 32.74' PK/remon tag W. face 8" Maple
S 40°E 16.90' PK/remon tag SW face 6" Maple

The selected location is accepted by the Contractor and is generally accepted by professional surveyors as the best available evidence of the position of the original corner. This corne was also accepted by the Oakland County Peer Group as established under Act 345 of P.A. 1990

Signed by James J. Scharl

Date Sept. 21, 1995

Surveyor's Michigan License No. 19843