

LSR 15709pc009

SEP 29 95 188800

LAND CORNER RECORDATION CERTIFICATE
Filing Requirement of Act 74, Mich. P.A. 1970

For corners in Oakland (County)

Located in:

Corner Code #

- 1. Public Land Survey T 4N R 10E A-9
2. Property Controlling in Section S T R
3. Miscellaneous Property in Section S T R

Compliance with ACT 345, P.A. 1990
APPROVED ON: 9-27-95 JMS
OAKLAND COUNTY REMONUMENTATION PEER GROUP COMMITTEE

Register of Deeds Stamp & File Number

- 4. Lot No. , Recorded Plat
5. Private Claims

I, James J. Scharl, in a field survey on 8-10, 19 95, do hereby certify that under requirements of P.A. 74, Michigan P.A. of 1970, the corner points mentioned in lines 1 and 2 above were in conformance with regulations and rules therefore as required in the current manual of survey instructions of the United States Department of the Interior, Bureau of Land Management or by a decree of a Court of Law and/or that the corner points mentioned in lines 3, 4 and 5 above were in conformance with the rules of the Michigan Board of Professional Surveyors or by a Decree of a Court of Law; established, re-established, monumented, re-monumented, recovered, found as expressed below:

Grid table with columns A-L and rows 2-13. A dot is marked at row 8, column A.

NOTE: Not more than 4 corners, all in the same town and range, may be recorded on this certificate.

A. Description of original monument and accessories and/or subsequent restoration:


Post set in 1817 G.L.O. survey.

- S 43°E 15 lks 8" Beech
N 74°E 46 lks 11" Beech

\$ 7.00 MISCELLANEOUS RECORDING
\$ 2.00 REMONUMENTATION
29 SEP 95 7:28 A.M. RECEIPT# 5B
PAID RECORDED - OAKLAND COUNTY
LYNN D. ALLEN, CLERK/REGISTER OF DEEDS

B. Description of corner evidence found and/or method applied in restoring or reestablishing corner:

Recovered iron with cap #15066 on centerline extension of Waldon Road to east and south. A fence/tree row runs north from the corner. Corner was set by Wozniak in 1989 survey of part of Section 19, T4N, R10E, and confirmed to be on the Township line.

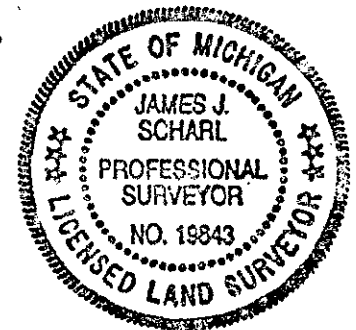

C. Description of monument for corner and accessories established to perpetuate locating the position of the corner:

Set 5/8" rerod with O.C. remonumentation brass cap, replacing rerod.

- N 05°W 25.58' PK/remon tag W face 12" Oak
N 30°E 68.63' PK/remon tag E face 12" Ash
S 25°W 37.84' PK/remon tag E face 10" Ash
S 30°E 75.56' PK/remon tag E face 16" Oak

The selected location is accepted by the Contractor and is generally accepted by professional surveyors as the best available evidence of the position of the original corner. This corner was also accepted by the Oakland County Peer Group as established under Act 345 of P.A. 199

Handwritten initials: J.A., 2nd, RW

Signed by James J. Scharl

Date September 18, 1995

Surveyor's Michigan License No. 19843