

LAND CORNER RECORDATION CERTIFICATE

Filing Requirement of Act 74, Mich. P.A. 1970 7.00 MISCELLANEOUS RECORDING

For corners in Oakland (County)

Located In:

Corner Code #

1. Public Land Survey	T	<u>4N</u>	R	<u>10E</u>	<u>A-11</u>
	T		R		
	T		R		
	T		R		
2. Property Controlling in Section	S		T	R	
	S		T	R	
3. Miscellaneous Property in Section	S		T	R	
	S		T	R	

\$ 2.00 REMONUMENTATION  
29 SEP 95 7:29 A.M. RECEIPT# 5B  
PAID RECORDED - OAKLAND COUNTY  
LYNN D. ALLEN, CLERK/REGISTER OF DEEDS

Compliance with ACT 345, P.A. 1990

APPROVED ON: 9-27-95 Tam S  
OAKLAND COUNTY REMONUMENTATION PEER GROUP COMMITTEE

Register of Deeds Stamp & File Number

4. Lot No. \_\_\_\_\_, Recorded Plat \_\_\_\_\_  
5. Private Claims \_\_\_\_\_

I, James J. Scharl, in a field survey on 8-10, 1995, do hereby certify that under requirements of P.A. 74, Michigan P.A. of 1970, the corner points mentioned in lines 1 and 2 above were in conformance with regulations and rules therefore as required in the current manual of survey instructions of the United States Department of the Interior, Bureau of Land Management or by a decree of a Court of Law and/or that the corner points mentioned in lines 3, 4 and 5 above were in conformance with the rules of the Michigan Board of Professional Surveyors or by a Decree of a Court of Law; established, re-established, monumented, re-monumented, recovered, found as expressed below:

A	B	C	D	E	F	G	H	I	J	K	L
2	6	5	4	3	2	1					
3											
4	7	8	9	10	11	12					
5											
6	18	17	16	15	14	13					
7											
8	19	20	21	22	23	24					
9											
10	30	29	28	27	26	25					
11											
12	31	32	33	34	35	36					
13											

NOTE: Not more than 4 corners, all in the same town and range, may be recorded on this certificate.

A. Description of original monument and accessories and/or subsequent restoration:

Post set in 1817 G.L.O. survey.


N 48°E 77 lks 9" W Oak  
S 46°E 50 lks 8" B Oak

LCRC, L 6083, P 34  
Stonerock, 1973, found 1" pipe  
\*North 14.41' nail in 8" Oak  
S 80°W 50.15' nail in 10" Peach

B. Description of corner evidence found and/or method applied in restoring or reestablishing corner:

Recovered 1" iron pipe 6" below grade in residential lawn. Tree lines run north and south from the recovered pipe. A new corner was set due west 0.77 ft from the 1" iron pipe on the Township line determined from traversing between the controlling Independence Township corners, holding the north-south position.

Witness Found to 1" Iron Pipe  
North 14.40' W face 16" Oak

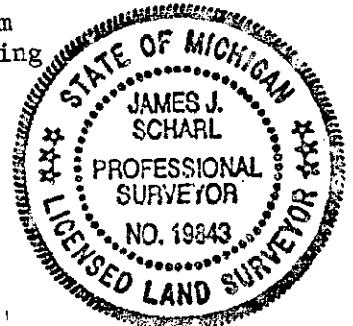

\*Confirms LCRC.

C. Description of monument for corner and accessories established to perpetuate locating the position of the corner:

Set concrete monument with O.C. remonumentation brass cap.

North 14.35' PK/remon tag W face 16" Oak  
South 5.65' PK/remon tag W face 20" Cherry  
West 49.00' PK/remon tag N face 22" Maple  
East 81.35' PK/remon tag N face 48" Oak  
East 0.77' 1" iron pipe

The position of the recovered 1" iron pipe was established using improper procedures and is referenced to give public notice of its erroneous existence. The selected location is a careful and faithful reestablishment of the position of the original corner. This corner is also accepted by the Oakland County Peer Group as established under Act 345 of P.A. 1990.

Signed by James J. Scharl Date Sept. 26, 1995

Surveyor's Michigan License No. 19843

7.00  
2.00  
R2