

**SURVEY & REMONUMENTATION**

LIBER **17634 PG 837**

APR 07 1998

**LAND CORNER RECORDATION CERTIFICATE**  
Filing Requirement of Act 74, Mich. P.A. 1970

For corners in **SECTION**

<u>Oakland</u> <small>(County)</small>	Located In, <u>Orion Twp.</u>	Corner Code #
1. Public Land Survey	T <u>4N</u> R <u>10E</u>	<u>B-13</u>
	T <u>    </u> R <u>    </u>	<u>    </u>
	T <u>    </u> R <u>    </u>	<u>    </u>
	T <u>    </u> R <u>    </u>	<u>    </u>
2. Property Controlling in Section	S <u>    </u> T <u>    </u> R <u>    </u>	<u>    </u>
	S <u>    </u> T <u>    </u> R <u>    </u>	<u>    </u>
3. Miscellaneous Property in Sec.	S <u>    </u> T <u>    </u> R <u>    </u>	<u>    </u>
	S <u>    </u> T <u>    </u> R <u>    </u>	<u>    </u>

**\$ 9.00 MISCELLANEOUS RECORDING**  
**\$ 2.00 REMONUMENTATION**  
29 SEP 97 12:45 P.M. RECEIPT# 147A  
PAID RECORDED - OAKLAND COUNTY  
LYNN D. ALLEN, CLERK/REGISTER OF DEEDS  
Compliance with ACT 345, P.A. 1990  
APPROVED ON: 7-23-97 JS  
OAKLAND COUNTY REMONUMENTATION PEER GROUP COMMITTEE  
Register of Deeds Stamp & File Number

4. Lot No. \_\_\_\_\_, Recorded Plat \_\_\_\_\_  
5. Private Claims \_\_\_\_\_

I, Huston K. Kennedy, in a field survey on 7/7, 19 97 do hereby state that under requirements of P.A. 74, Michigan P.A. of 1970, the corner points mentioned in lines 1 and 2 above were in conformance with regulations and rules therefore as required in the current manual of survey instructions of the United States Department of the Interior, Bureau of Land Management or by a decree of a Court of Law and/or that the corner points mentioned in lines 3, 4 and 5 above were in conformance with the rules of the Michigan Board of Land Surveyors or by a Decree of a Court of Law; established, re-established, monumented, recovered, found as expressed below:

NOTE: Not more than 2 corners, all in the same town and range, may be recorded on this certificate.

	A	B	C	D	E	F	G	H	I	J	K	L	M
1													
2		6		5		4		3		2		1	
3													
4		7		8		9		10		11		12	
5													
6		18		17		16		15		14		13	
7													
8		19		20		21		22		23		24	
9													
10		30		29		28		27		26		25	
11													
12		31		32		33		34		35		36	
13													

A. Description of original monument and accessories and/or subsequent restoration:  
1817-GLO Wampler, D.S.; Set Post 4" Ash N53°W 19 Links

B. Description of corner evidence found and/or method applied in restoring or reestablishing corner:  
1997 Kennedy Surveying, Inc. - Kennedy, PS #17623 - Fnd a rock .40 feet x 1.00 feet and 1.50 feet above the surface at a fence corner with a fence line extending to the North, East & West.

Lines of occupation and sidwell distances were used to recover and verify the location of the found rock.

I accepted the found rock as the best evidence of the original corner position.


Field measurements see back side of LCRC

C. Description of monument for corner and accessories established to perpetuate locating the position of the corner:  
B-13 I accepted the found rock and epoxyed a 2" diameter brass cap stamped Oakland County Remonumentation, PS #17623 to the rock  
N03°W 22.72' Set PK & Remon Washer West face 19" Hickory  
Due South 42.74' Set PK & Remon Washer East face 18" & 19" twin Oak  
S55°W 24.69' Set PK & Remon Washer NW face 8" Oak  
S72°E 9.91' Set PK & Remon Washer SW face 6" Hickory

The selected location is accepted by me and is generally accepted by Professional Surveyors as the best available evidence of the position of the original corner.

Signed by [Signature]  
Surveyor's Michigan License No. 7623

Date 8-15-97

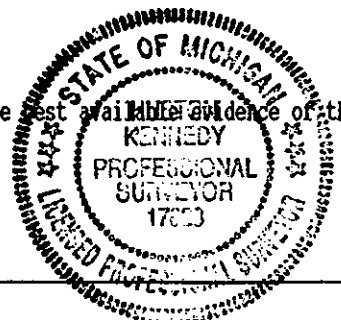

SP 29 97 231990

SURVEY &  
REMONUMENTATION

APR 07 1998

SECTION

LIBER 17634 PG 838

FIELD MEASUREMENTS BETWEEN

B-13 to A-13

GLO = 40 chains or 2640.00 Ft.  
No sidwell or plat distances  
GPS-MEA = 2936.23 Ft.

B-13 to C-13

GLO = 40 chains or 2640.00 Ft.  
Sidwell distance = 1648.13 Ft. (Section 31)  
GPS-MEA = 1650.49 Ft.