SURVEY & REMONUMENTATION

LIBER 14960 PG 110 94 242440

MAY - 1 1995

COMMISSION

LAND CORNER RECORDATION CERTIFICATE

Filing Requirement of Act 74, Mich. P.A. 1970

OK - T. SMITH

For corners in Oakland (County) Located In: Orion Township Corner Code #

$ 7.00 MISCELLANEOUS RECORDING
$ 2.00 REMONUMENTATION
8 SEP 94 3:18 P.M. RECEIPT# 1348
PAID RECORDED - OAKLAND COUNTY
LYNN D. ALLEN, CLERK/REGISTER OF DEEDS

1. Public Land Survey		T 4 N	R 10 E	E-1
		T ___	R ___	
		T ___	R ___	
		T ___	R ___	
2. Property Controlling	S ___	T ___	R ___	
in Section	S ___	T ___	R ___	
3. Miscellaneous	S ___	T ___	R ___	
Property in Sec.	S ___	T ___	R ___	

Compliance with ACT 345, P.A. 1990

APPROVED ON: 1-5-94
OAKLAND COUNTY REMONUMENTATION PEER GROUP COMMITTEE
Register of Deeds Stamp & File Number

4. Lot No. _____ , Recorded Plat _____
5. Private Claims _____

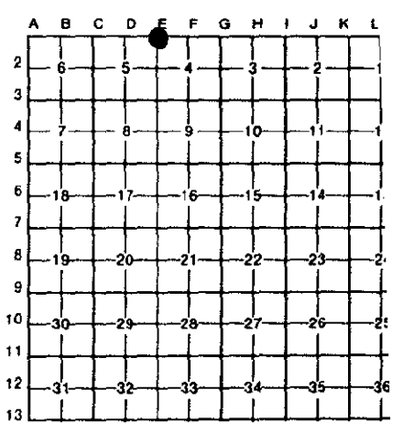

I, Huston K. Kennedy, in a field survey on November 11, 19 93, do hereby certify that under requirements of P.A. 74, Michigan P.A. of 1970, the corner points mentioned in lines 1 and 2 above were in conformance with regulations and rules therefore as required in the current manual of survey instructions of the United States Department of the Interior, Bureau of Land Management or by a decree of a Court of Law and/or that the corner points mentioned in lines 3, 4 and 5 above were in conformance with the rules of the Michigan Board of Land Surveyors or by a Decree of a Court of Law; established, re-established, monumented, re-monumented, recovered, found as expressed below:

NOTE: Not more than 4 corners, all in the same town and range, may be recorded on this certificate.

A. Description of original monument and accessories and/or subsequent restoration:

1817-GLO Wampler, D.S.; Set Post; 24" Pine N19°W 50 Lnks; 8" Black Oak S26 1/2°E 34 Lnks
1988-Kennedy, P.S. #17623; LCRC L.10709, Pg.794 - Fnd 1/2" Iron Rod
1993-Carlson, P.S. #9189; LCRC L.13471, Pg.040 - Fnd 3/4" Iron Rod

B. Description of corner evidence found and/or method applied in restoring or reestablishing corner:

1993 Kennedy Surveying, Inc. - Kennedy, P.S. #17623 - Fnd a 3/4" Iron Rod located 3' North o the center of Stanton Road, which is a gravel surface road. There is a tree line extendin to the South. A 1/2" Iron Rod was found that is 10.50' East of the Section corner.

Witness points from the 1993 LCRC were found and they were used to recover and verify th found 3/4" Iron Rod.

I accepted the found 3/4" iron rod as the best evidence of the original corner position.

C. Description of monument for corner and accessories established to perpetuate locating the position of the corner:

E-1 I replaced the found 3/4" iron rod with a 5/8" x 24" iron rod with a 2" diameter cap stamped Oakland County Remonumentation P.S. #17623.

S05°W-19.34 ft-Set PK & Remon. Washer above existing witness in East face 10" Oak
S15°E-38.49 ft-Set PK & Remon. Washer above existing witness in East face 14" Oak
N47°W-24.16 ft-Set PK & Remon. Washer above existing witnesses in SW face [illegible] Elm
N12°W-23.72 ft-Set PK & Remon. Washer in East face 11" Oak

The selected location is accepted by me and is generally accepted by Professional Surveyors as the best available evidence of the position of the original position.

STATE OF MICHIGAN HUSTON KENNEDY PROFESSIONAL SURVEYOR 17623 LICENSED PROFESSIONAL SURVEYOR

Signed by _____ Date June 22, 1994

Surveyor's Michigan License No. 17623

FORM APPROVED BY MICHIGAN STATE BOARD OF LAND SURVEYORS JAN. 28, 1971
REVISED MAY 14, 1975
REVISED JAN., 1983