

COPY

LAND CORNER RECORDATION CERTIFICATE
Filing Requirement of Act 74, Mich. P.A. 1970

\$ 7.00 MISCELLANEOUS RECORDING
\$ 2.00 REMONUMENTATION
3 JAN 97 7:44 A.M. RECEIPT# 7B
PAID RECORDED - OAKLAND COUNTY
LYNN D. ALLEN, CLERK/REGISTER OF DEEDS

For corners in

Oakland
(County)


Located In Orion Twp Corner Code #

1. Public Land Survey	T <u>4</u> N	R <u>10</u> E	E-3
	T	R	
	T	R	
	T	R	
2. Property Controlling in Section	S	T	R
	S	T	R
3. Miscellaneous Property in Sec.	S	T	R
	S	T	R

Compliance with ACT 345, P.A. 1990
APPROVED ON: 12-17-96 TS
OAKLAND COUNTY REMONUMENTATION
PRER GROUP COMMITTEE

Register of Deeds Stamp & File Number

4. Lot No. _____, Recorded Plat _____
5. Private Claims _____

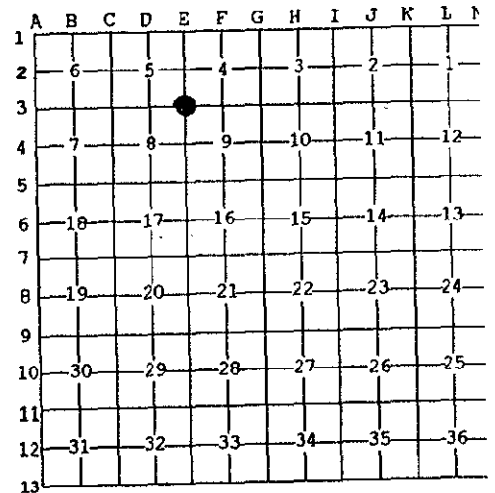

I, Huston K. Kennedy, in a field survey on 11/20, 1996 do hereby state that under requirements of P.A. 74, Michigan P.A. of 1970, the corner points mentioned in lines 1 and 2 above were in conformance with regulations and rules therefore as required in the current manual of survey instructions of the United States Department of the Interior, Bureau of Land Management or by a decree of a Court of Law and /or that the corner points mentioned in lines 3, 4 and 5 above were in conformance with the rules of the Michigan Board of Land Surveyors or by a Decree of a Court of Law, established, re-established, monumented, recovered, found as expressed below:

NOTE: Not more than 2 corners, all in the same town and range, may be recorded on this certificate.

A. Description of original monument and accessories and/or subsequent restoration:

- 1817-GLO Wampler, D.S.; Set Post 12" Tamarac N97°E 126 Links; 13" Tamarac S15°W 68 Links
- 1.) 1992-Kennedy, PS #17623; LCRC L.12869, Pg.825 - Fnd 2" Iron Pipe
- 2.) 1982-Kennedy, PS #17623; Unrecorded Survey - Fnd 2" Iron Pipe, used same wit as 1992 LCRC
- 3.) 1992-Kennedy, PS #17623; Unrecorded Survey - Fnd 2" Iron Pipe, used same wit as 1992 LCRC
- 4.) 1993-Kennedy, PS #17623; Unrecorded Survey - Fnd 2" Iron Pipe, used same wit as 1992 LCRC
- 5.) 1994-Kennedy, PS #17623; Unrecorded Survey - Fnd 2" Iron Pipe, used same wit as 1992 LCRC

SURVEY & REMONUMENTATION

MAY 22 1997

COMMISSION

B. Description of corner evidence found and/or method applied in restoring or reestablishing corner:

1996 Kennedy Surveying, Inc. - Kennedy, PS #17623 - Fnd 2" Iron Pipe 24" long 90 feet ± East of Green Lake and 78 feet ± North of path.

Witnesses from LCRC #1 were used to recover and verify the location of the found 2" Iron Pipe.

I accepted the found 2" Iron Pipe as the best evidence of the original corner position.

FIELD MEASUREMENTS BETWEEN

- E-3 to E-2 GLO = 40 chains or 2640.00 Ft., 2515.19 Ft. (MEA 1982)
- E-3 to E-4 GLO = 40 chains or 2640.00 Ft., 2696.48 Ft. (MEA 1996)

C. Description of monument for corner and accessories established to perpetuate locating the position of the corner:

E-3 I replaced the found 2" Iron Pipe with a 4" diameter Concrete Monument 36" long with 1/2" Iron Rod w/2" diameter brass cap stamp

Oakland County Remonumentation, PS #17623
 N47°W 33.35' Set PK & Remon Washer SE face 10" Oak
 S67°W 27.82' Set PK & Remon Washer NW face 14" Poplar
 Due South 15.72' Set PK & Remon Washer East face 7" Oak
 N86°E 17.09' Set PK & Remon Washer South face 14" Oak

The selected location is accepted by me and is generally accepted by Professional Surveyors as the best available evidence position of the original corner.

Signed by _____
Surveyor's Michigan License No. 17623

Date December 18, 1996

